

SCALE 1" = 1320'



Primary water from Well # 3 as authorized under G-15066.

WELL TIED LOCATIONS

WELL #3
S 15.0' and East 3200.5' from the NW corner of
Sec. 21, T3S R39E, WM

Latitude: 45°17'49.30312" N
Longitude: 117°56'24.26220" W

RECEIVED

JAN 22 2019

OWRD


MAP OF BENEFICIAL USE FOR THE IRRIGATION
OF 8.1 ACRES FROM WELL NUMBER 3
AUTHORIZED UNDER PERMIT G-15066

FOR
LANE FARMS, INC. ROB LANE
BY
GREG BLACKMAN WATER RIGHTS
126 RIDGE DRIVE
LAGRANDE, OREGON 97850

NOVEMBER 28, 2018

APPLICATION NO. G 15073

PERMIT NUMBER G 15066

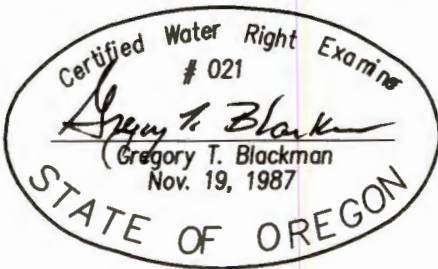

NOTE: The preparation of this map was for the purpose of identifying the location of the proposed water right and has no intent to provide dimensions or location of property ownership lines. Location information shown hereon was furnished by the applicant.