


Howell Reservoir Application Map Township 2 South Range 40 East, W.M.

RECEIVED

SEP 17 2018

OWRD

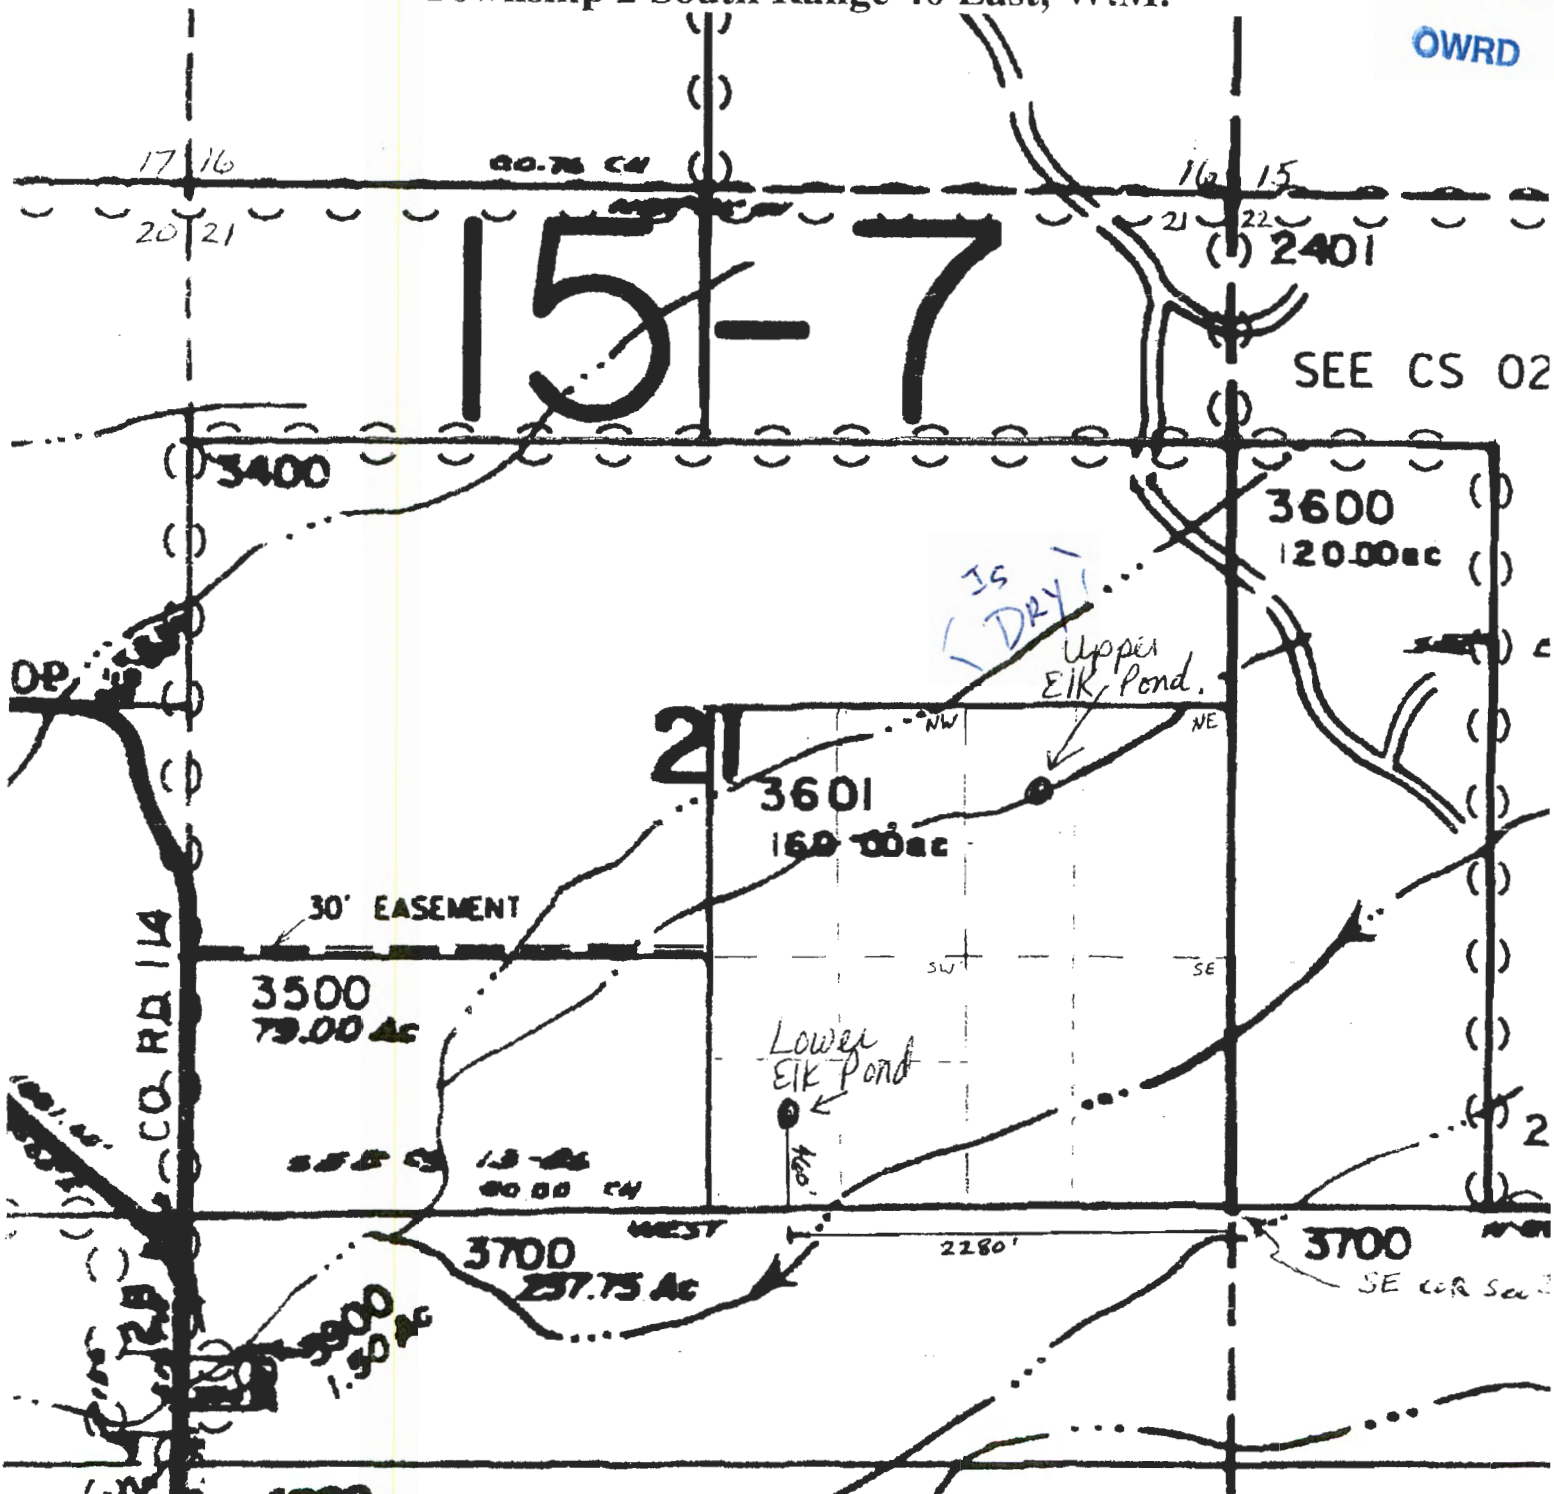

map scale 1" = 1000'

RECEIVED

AUG 14 2006

WATER RESOURCES DEPT
SALEM, OREGON

RECEIVED

OCT 02 2018

OWRD

RECEIVED
OVER THE COUNTRY

RECEIVED

JUN 29 2006

WATER RESOURCES DEPT
SALEM, OREGON

no R-810106