


# Claim of Beneficial Use

## T-10480



T14S, R11E, W.M.  
Deschutes Co., OR


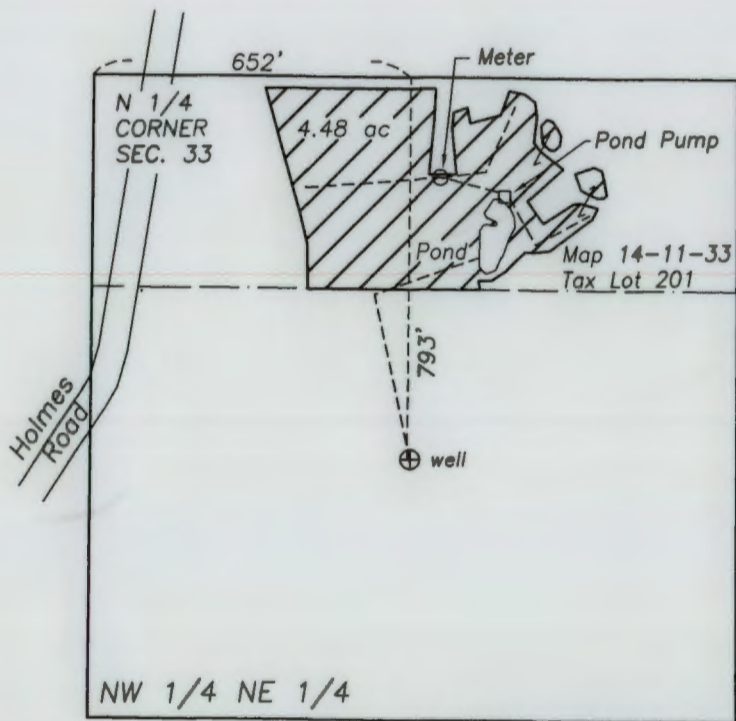


Water beneficially applied under  
T-10480  
(priority date March 10, 1994)




Mainline

RECEIVED BY DWT/O  
SEP 19 2016  
DALEM, OR

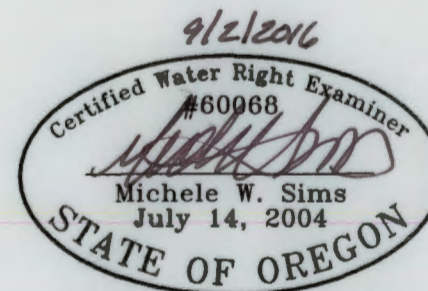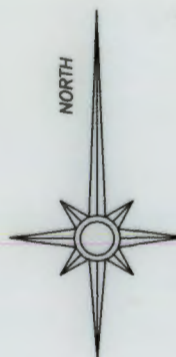

Renewal date: 6/30/2018

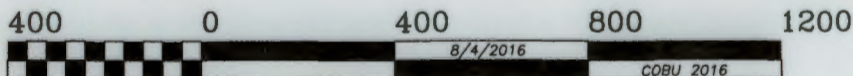

GRAPHIC SCALE - FEET

THIS MAP IS FOR THE PURPOSE OF IDENTIFYING THE LOCATION OF THE WATER RIGHT. IT IS NOT INTENDED TO PROVIDE LEGAL DIMENSIONS OR LOCATIONS OF PROPERTY OWNERSHIP LINES.