


SEC. 3, T.23S., R.32½E., W.M.

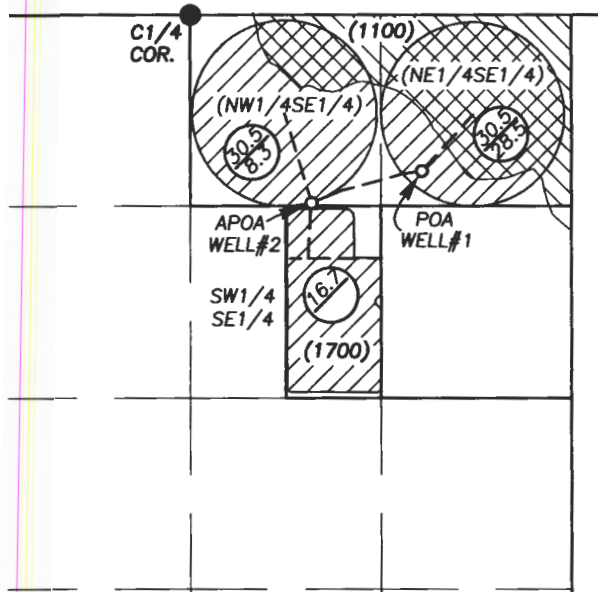

SCALE: 1"=1320'

POA-WELL #1 & FLOW METER 1080 FT. SOUTH & 1600 FT. EAST OF THE C1/4 COR. SEC. 3,

APOA-WELL #2 & FLOW METER 1300 FT. SOUTH & 840 FT. EAST OF THE C1/4 COR. SEC. 3,

THE WATER RIGHT FOR IRRIGATION OF 36.8 ACRES UNDER CERTIFICATE 15532 IS DIMINISHED FROM PRIMARY IRRIGATION TO SUPPLEMENTAL IRRIGATION. THE SOURCE IS SURPLUS AND WASTE WATER, TRIBUTARY TO COW CREEK. THIS WATER IS USED WHEN AVAILABLE VIA FLOOD IRRIGATION.

NOTE: FOUND A 1/2" IRON PIN AT C1/4 CORNER SEC. 3 AND A BRASS DISC WITNESS CORNER MONUMENT 40 FT. SOUTH OF CORNER POSITION

FINAL PROOF SURVEY

UNDER

APPLICATION NO. T-10361

PERMIT NO. SPECIAL ORDER - 79-265

IN NAME OF

AMANDA ZGRAGGEN

 CURRENT PLACE OF USE - PRIMARY

 CURRENT PLACE OF USE - SUPPLEMENTAL

 WELL AND FLOW METER

----- BURIED MAINLINE WITH RISERS

() TAX LOT NO

● FOUND 1/2" IRON PIN AT CENTER 1/4 COR. SEC. 3

 PRIMARY ACRES
SUPPLEMENTAL ACRES

RECEIVED BY OWRD


AUG 29 2016

SALEM, OR

PREPARED BY

ROBERT D. BAGETT
217 N. CANYON BLVD.
JOHN DAY, OR 97845

DATE SURVEYED: JULY 11, 2016

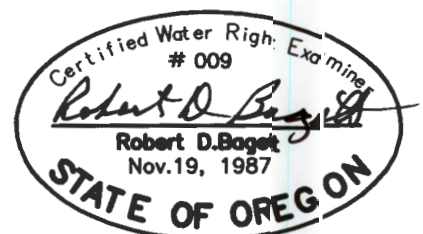

DISCLAIMER: THIS MAP IS NOT INTENDED TO PROVIDE LEGAL DIMENSIONS OR LOCATIONS OF PROPERTY OWNERSHIP LINES.

RENEWS: 12/31/2017