
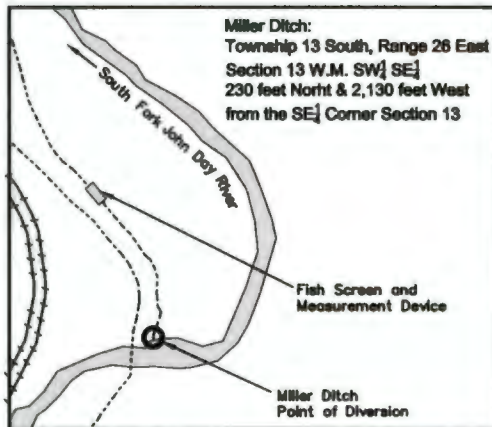
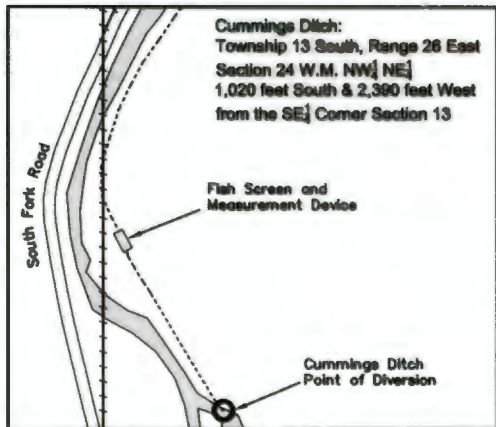


FINAL PROOF SURVEY

Lee Schrier

Transfer No. 10938

Township 13 South, Range 26 East, Section 13 W.M.

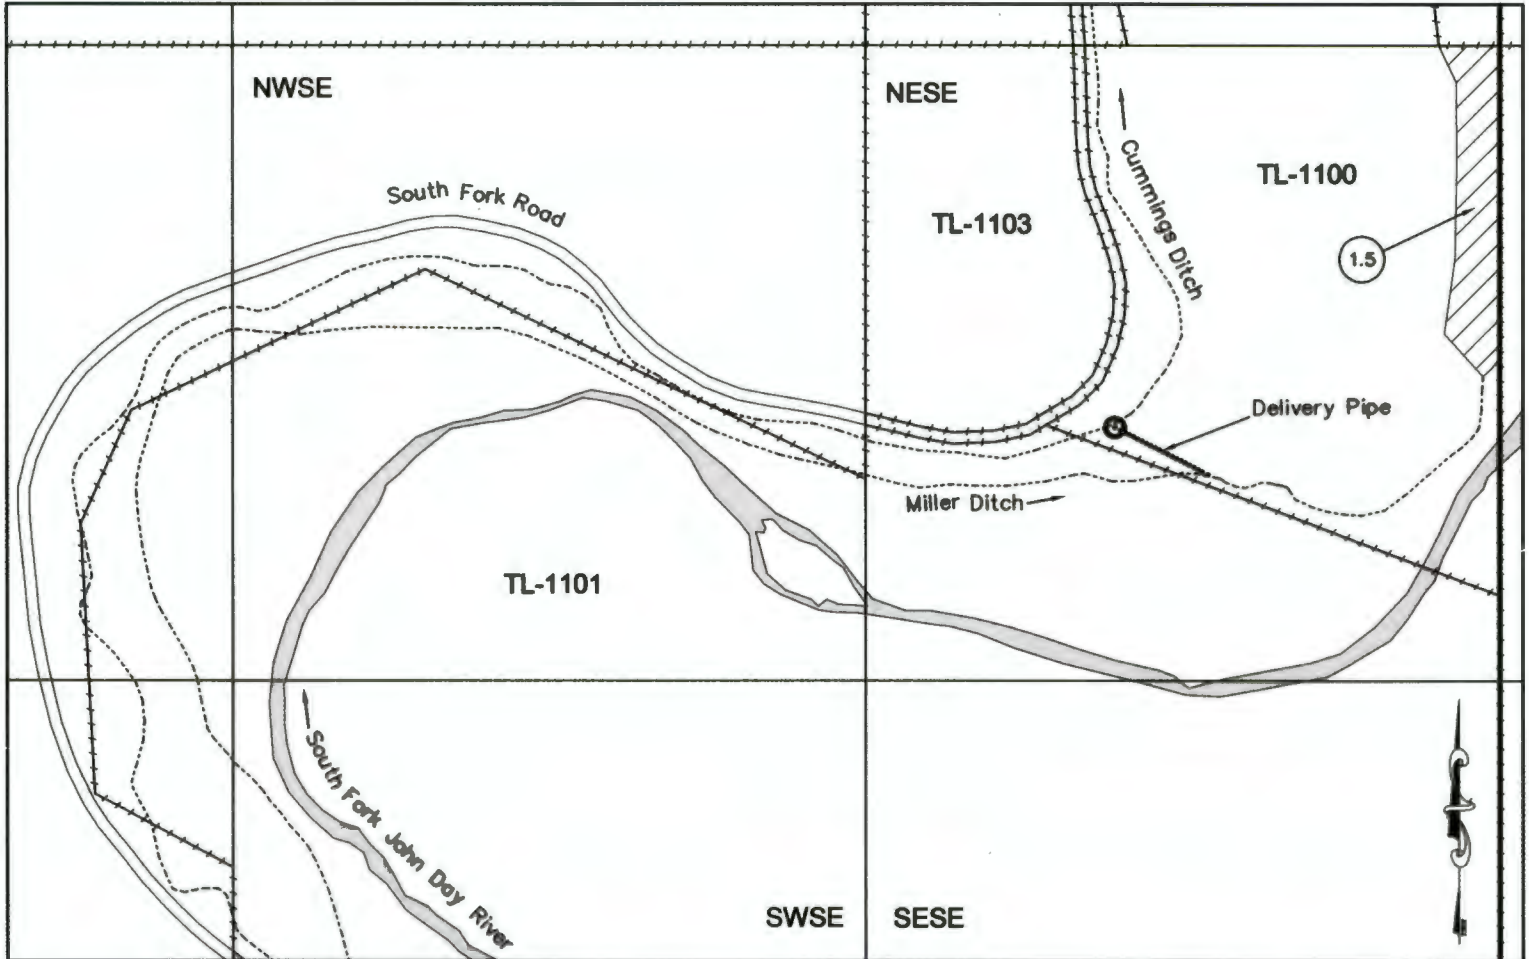

TL-1101	TL-2100
13	18
24	19
TL-2301	TL-2002

LEGEND


- Located Section Corner
- Property Boundary
- Irrigation Ditch
- Diversion / Turnout
- Acres

Scale: 1" = 400'

RECEIVED BY OWRD

OCT 02 2015

SALEM, OR

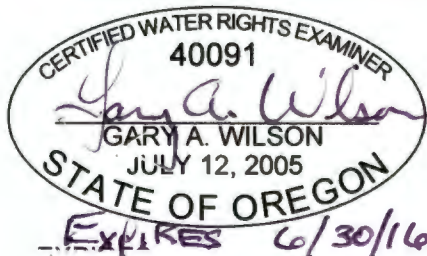

This map is not intended to provide legal dimensions or location of property ownership lines.