


OWRD RECEIVED

Ann Reece, 11/5/2021, 10:04:55 AM

T. 8S. R. 39E. W.M.

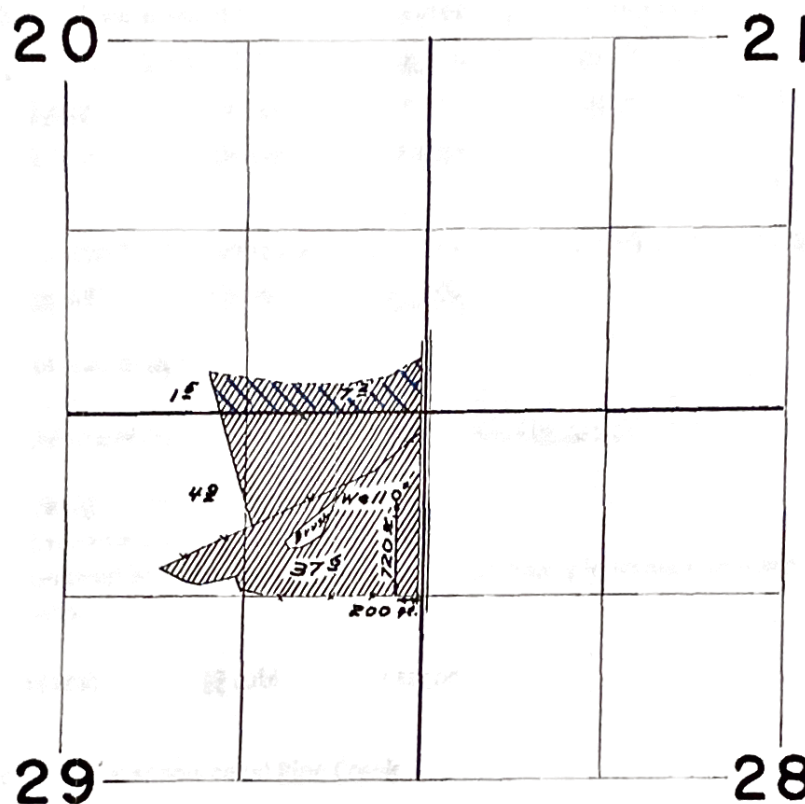

Certificate 34317

51.2 Acres

FINAL PROOF SURVEY

UNDER

(8.7 Ac to be cancelled in TL 1900)

Application No. G-2985 Permit No. G-2768
IN NAME OF

A.F. Moser

Surveyed Aug. 9, 1956, by W.D. Ruppert

RECEIVED

OCT 08 2021

OWRD