


T. 8S R. 39E

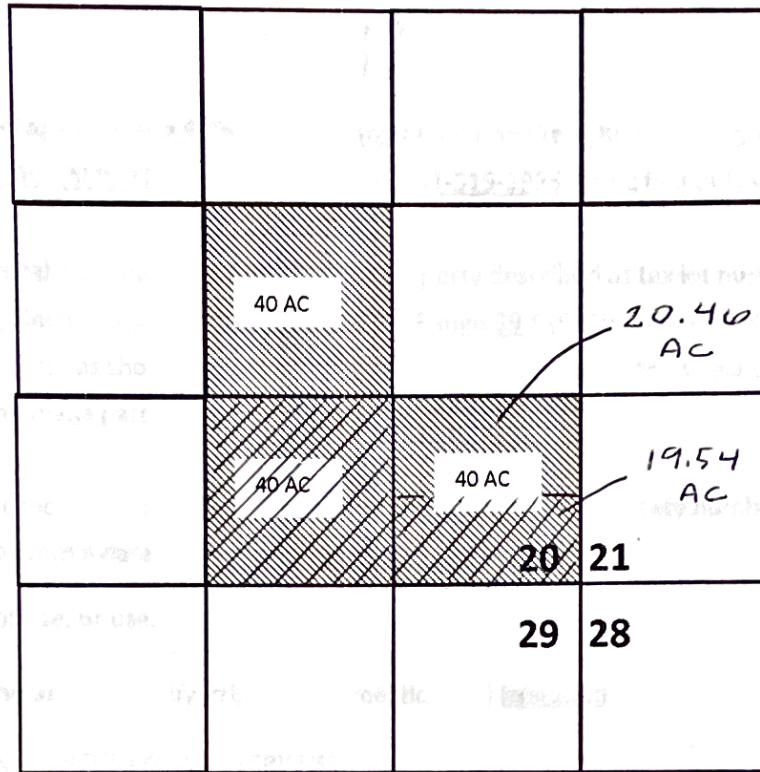

60.46 AC remaining  
water rights

59.54 AC to be  
cancelled in TL 1900

## CANCELLATION MAP

Certificate 73612

120 Acres

(59.54 AC to be cancelled in TL 1900)