


T. 8 S. R. 39 E. W. M.

Map for Partial Cancellation of Certificate 86092

Cancellation of 59.54 acres

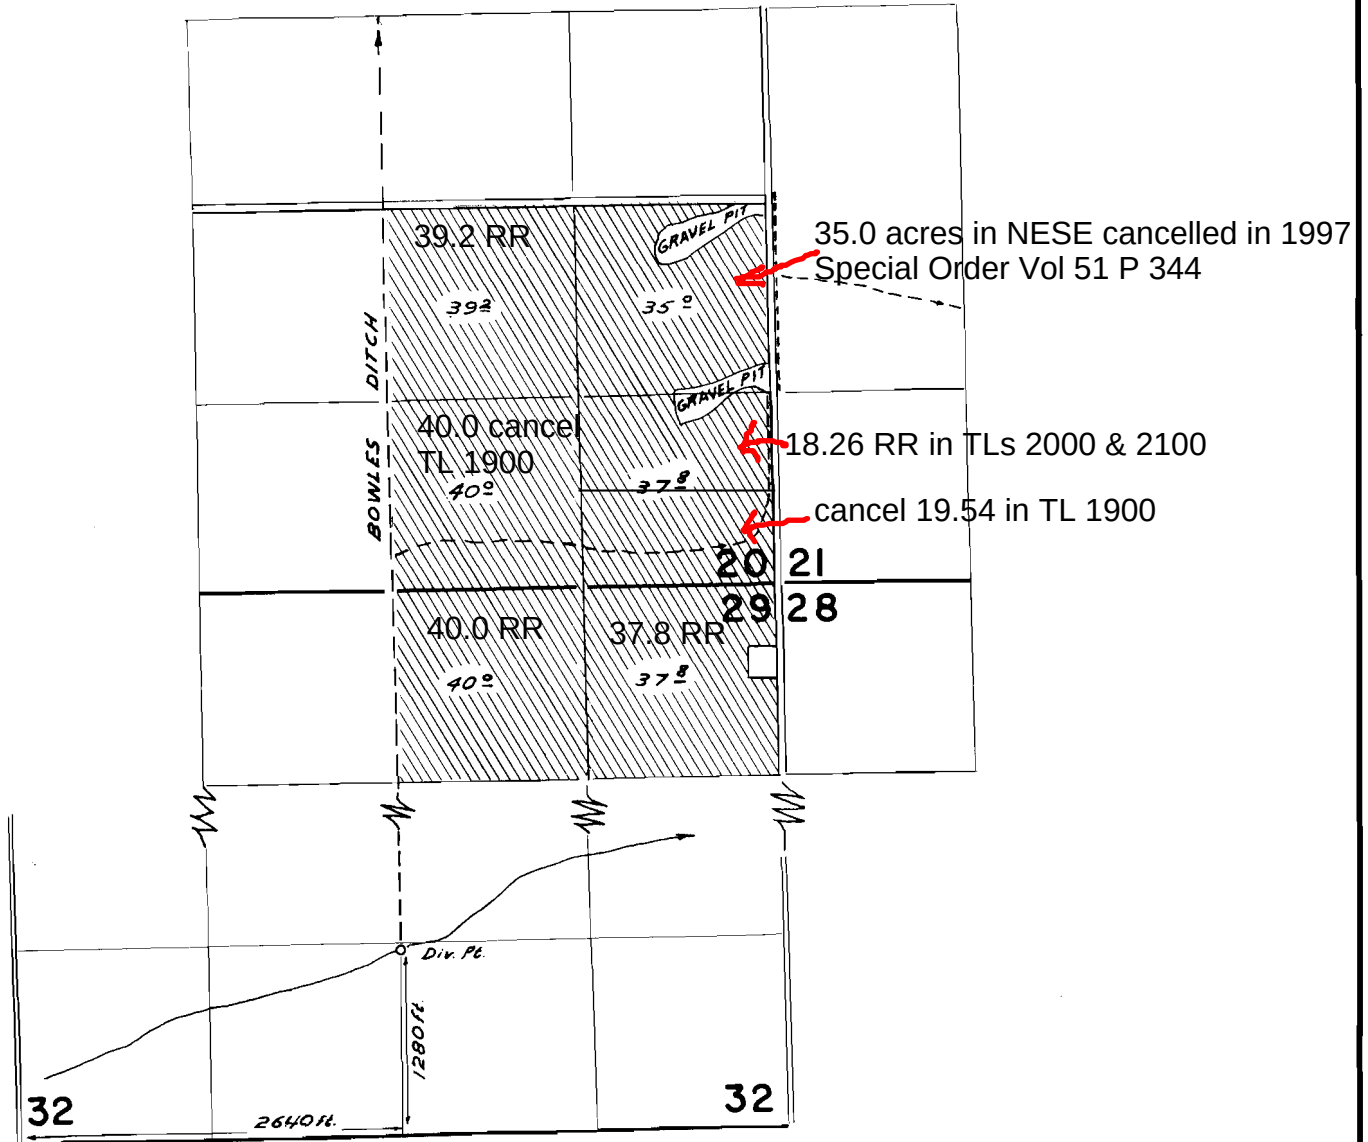

FINAL PROOF SURVEY
UNDER

Application No. 33512 Permit No. 26506
IN NAME OF

ALVIN F. MOSER

Surveyed NOV. 16, 17 1964, by C. GARDNER