
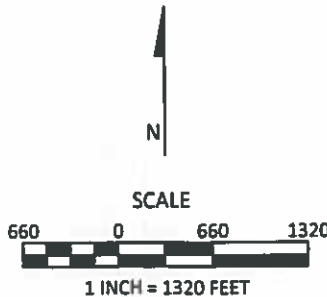
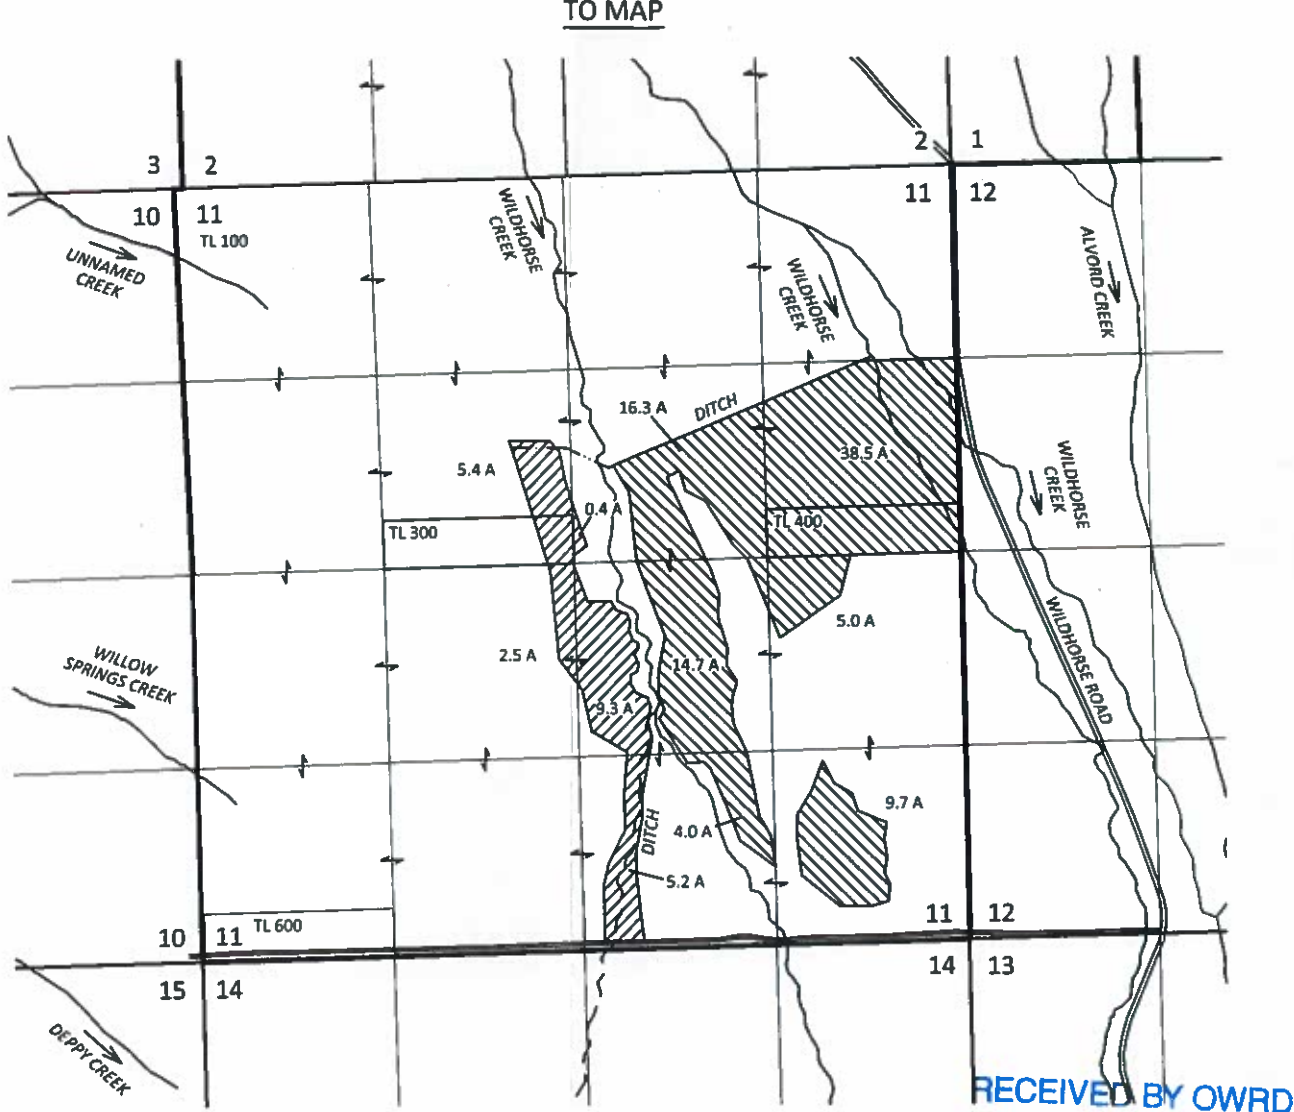


TRANSFER APPLICATION MAP Certificates 88588 & 88589 Section 34, T34S, R33E and Sections 1, 2 & 11, T35S, R33E, W.M., Harney County, Oregon

George Stroemple

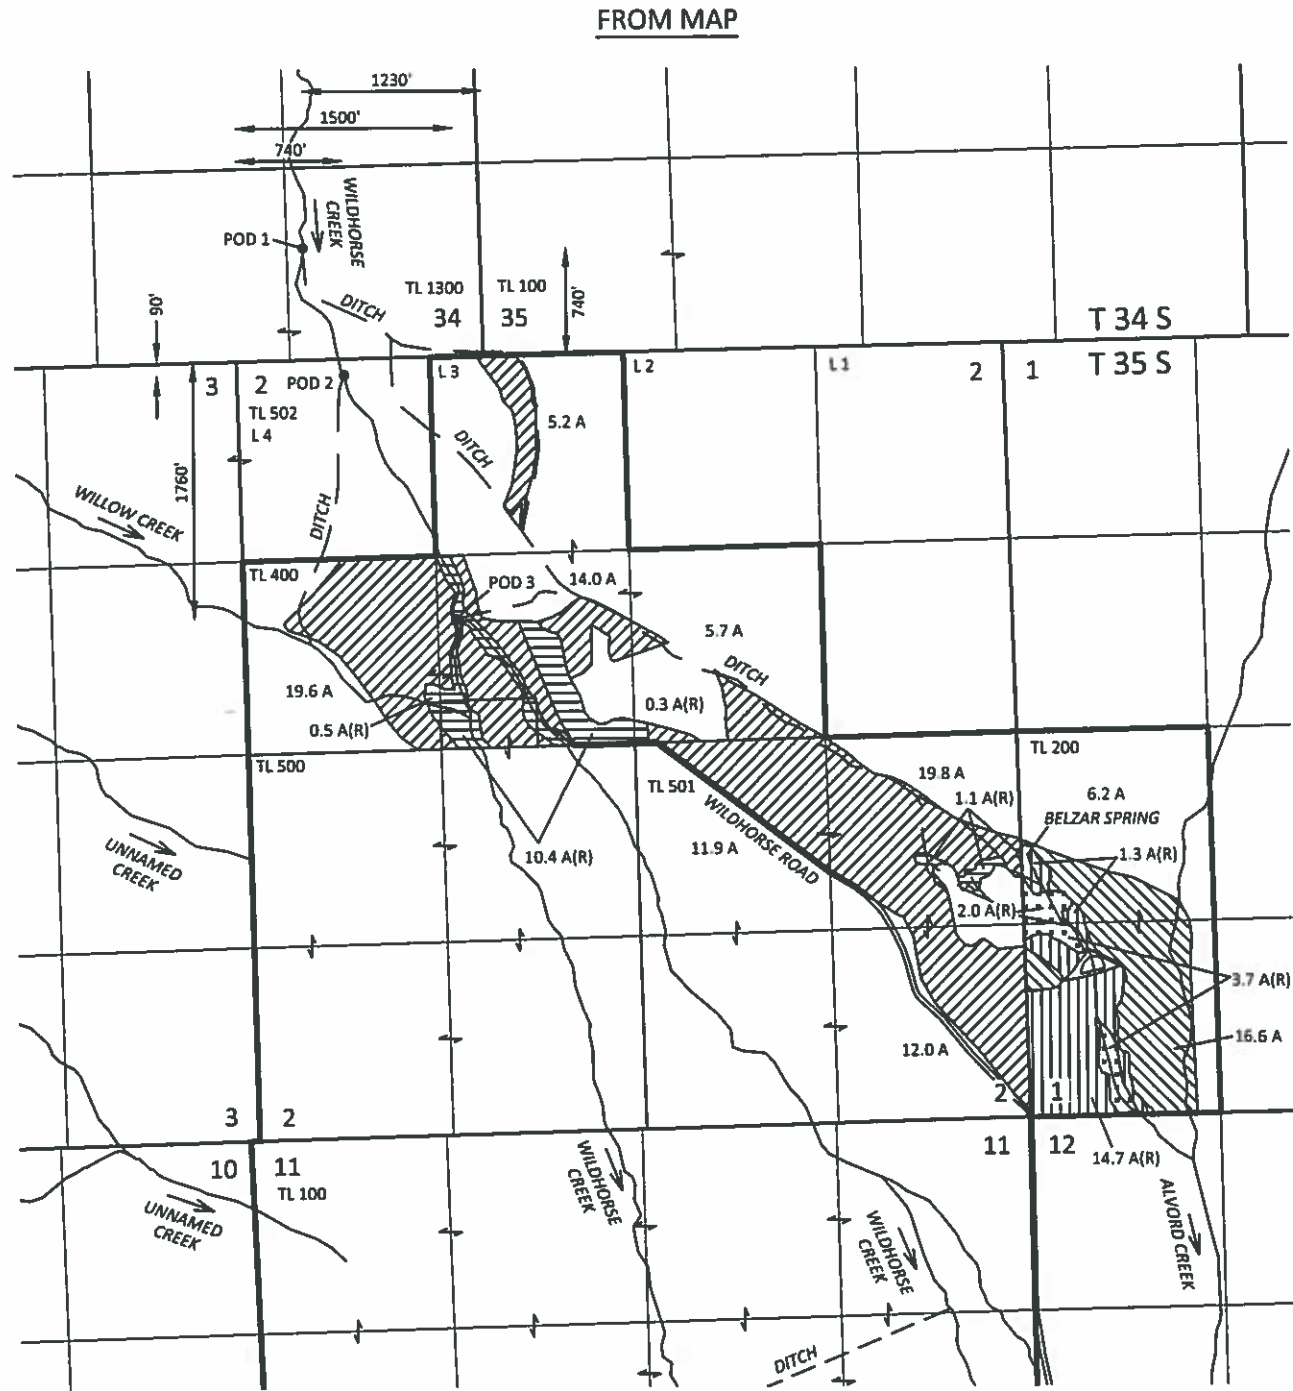

December 22, 2016
 This map is not intended to provide legal
 dimensions or locations of property
 ownership lines

Figure 1

SKOOKUM
 WATER ASSOCIATES INC
 P.O. BOX 80174
 PORTLAND, OR 97280
 (503) 319-8926

DRAFT

EXPLANATION	
FROM LANDS	TO LANDS
CERTIFICATE 88588 (88.2 A) IRRIGATION PRIORITY: 6/27/1978	CERTIFICATE 88588 (88.2 A) IRRIGATION PRIORITY: 6/27/1978
CERTIFICATE 88589 (22.8 A) IRRIGATION PRIORITY: 6/27/1978	CERTIFICATE 88589 (22.8 A) IRRIGATION PRIORITY: 6/27/1978
POINT OF DIVERSION (POD)	POINT OF DIVERSION (POD)
PIPELINE (APPROX.)	PIPELINE (APPROX.)
DITCH	DITCH
REMAINING RIGHTS	
CERTIFICATE 88588 (12.3 A) IRRIGATION PRIORITY: 6/27/1978	CERTIFICATE 88588 (12.3 A) IRRIGATION PRIORITY: 6/27/1978
CERTIFICATE 88589 (16.0 A) IRRIGATION PRIORITY: 6/27/1978	CERTIFICATE 88589 (16.0 A) IRRIGATION PRIORITY: 6/27/1978
CERTIFICATE 88589 (5.7 A) SUPPLEMENTAL IRRIGATION PRIORITY: 6/27/1978	CERTIFICATE 88589 (5.7 A) SUPPLEMENTAL IRRIGATION PRIORITY: 6/27/1978

1 12573