


T.23 S.R.31 E.W.M.

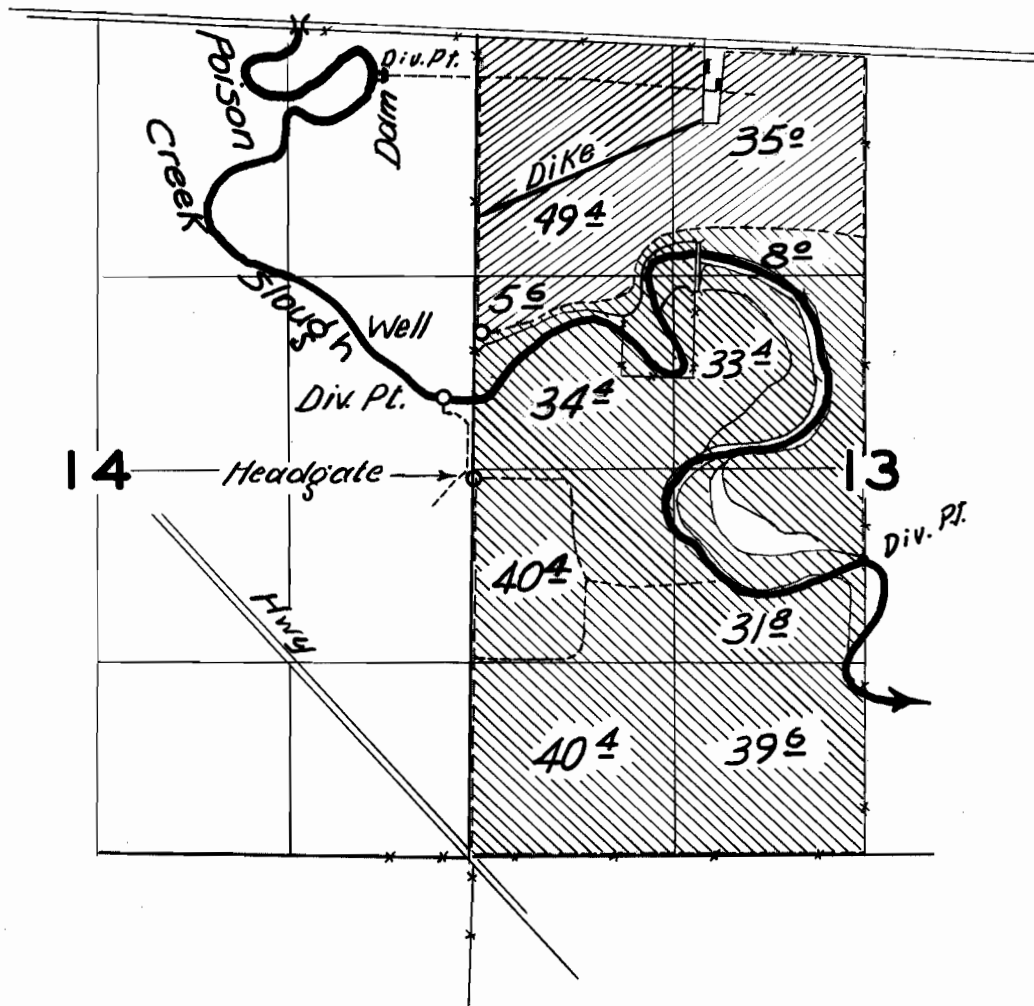

FINAL PROOF SURVEY

UNDER

U-112

4-380

Application No. 25685 Permit No. 20133

IN NAME OF

C. D. Falk

Surveyed June 25, 1951, by H. L. Hoffman


T23S R31E, WM, HARNEY COUNTY, OR

- Well
- Stream/Ditch
- Pipeline
- Township
- Section
- Quarter Quarter


Well Locations:

Well #1 (HARN 443):
1380' N, 1230' E of SW Cor Sec 13

Well #2 (HARN 52256):
2060' S, 100' E of NW Cor Sec 13

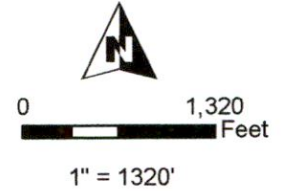

- Tax Lot
- C-20809 POU IS "OFF"
- C-20809 POU IS "UNCHANGED"
- C-46392 POU IS "OFF"

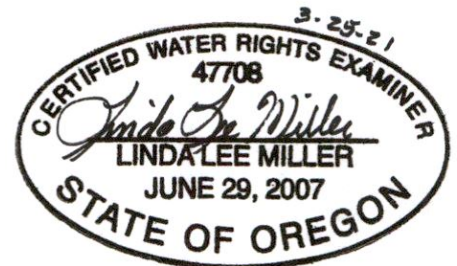


RENEWAL DATE 12/31/2022

RECEIVED

APR 19 2021

OWRD

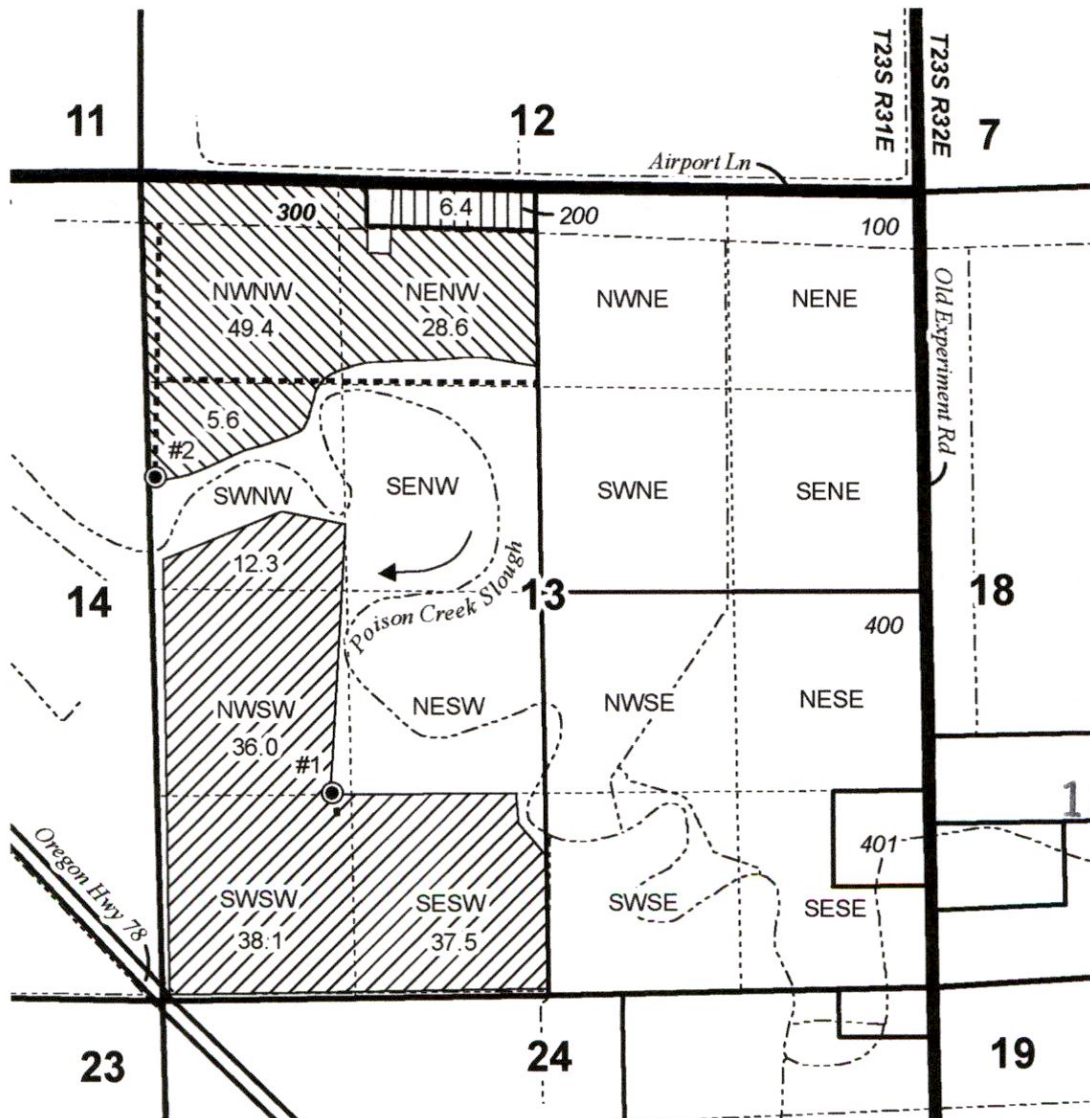

13 6 7 9 -



**PERMANENT TRANSFER "OFF" MAP
3J CATTLE COMPANY**

C-20809 & C-46392

Date: 3/25/2021

This map is not intended
to provide legal dimensions
or locations of property
ownership lines.

WATER RIGHT SERVICES, LLC
PO BOX 1830, BEND, OR 97709
WWW.OREGONWATER.US CCB # 197121
johnshort@usa.com 541-389-2837