


# Claim of Beneficial Use Map for David Roth



Scale 1" = 1320'  
(4" = 1 mile)

T-11421

- ⊘ 18<sup>±</sup> acres (8/2/73)
- ⊘ 19<sup>±</sup> acres (9/15/83)

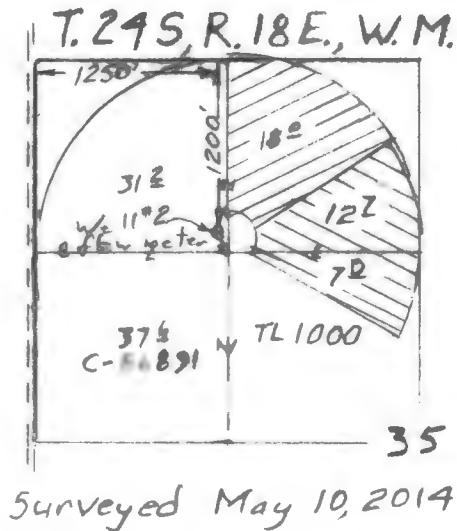

RECEIVED

DEC 16 2019

OWRD

This map is for the purpose of locating a water right only and has no intent to provide legal dimensions or the location of property lines.



Renewal Dec 31 2015

**ESTES SURVEYS, LLC**  
 PO Box 17819      60382 Amold Rd  
 Salem, OR 97300-7519      Bend, OR 97702  
 (503) 585-7393      (541) 382-7391