
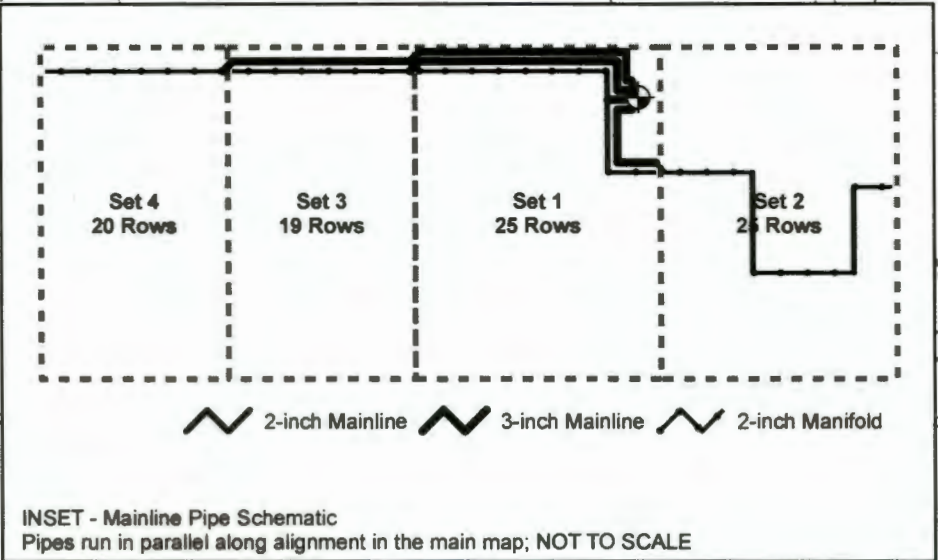


Claim of Beneficial Use Map
 Township 1S, Range 4E, W.M.
 SE1/4 of NE 1/4, Section 03 - 7.9 acres Irrigation
 NE1/4 of SE 1/4, Section 03 - 11.5 acres Irrigation

Permit #: G-15629
 Application #: G-16122

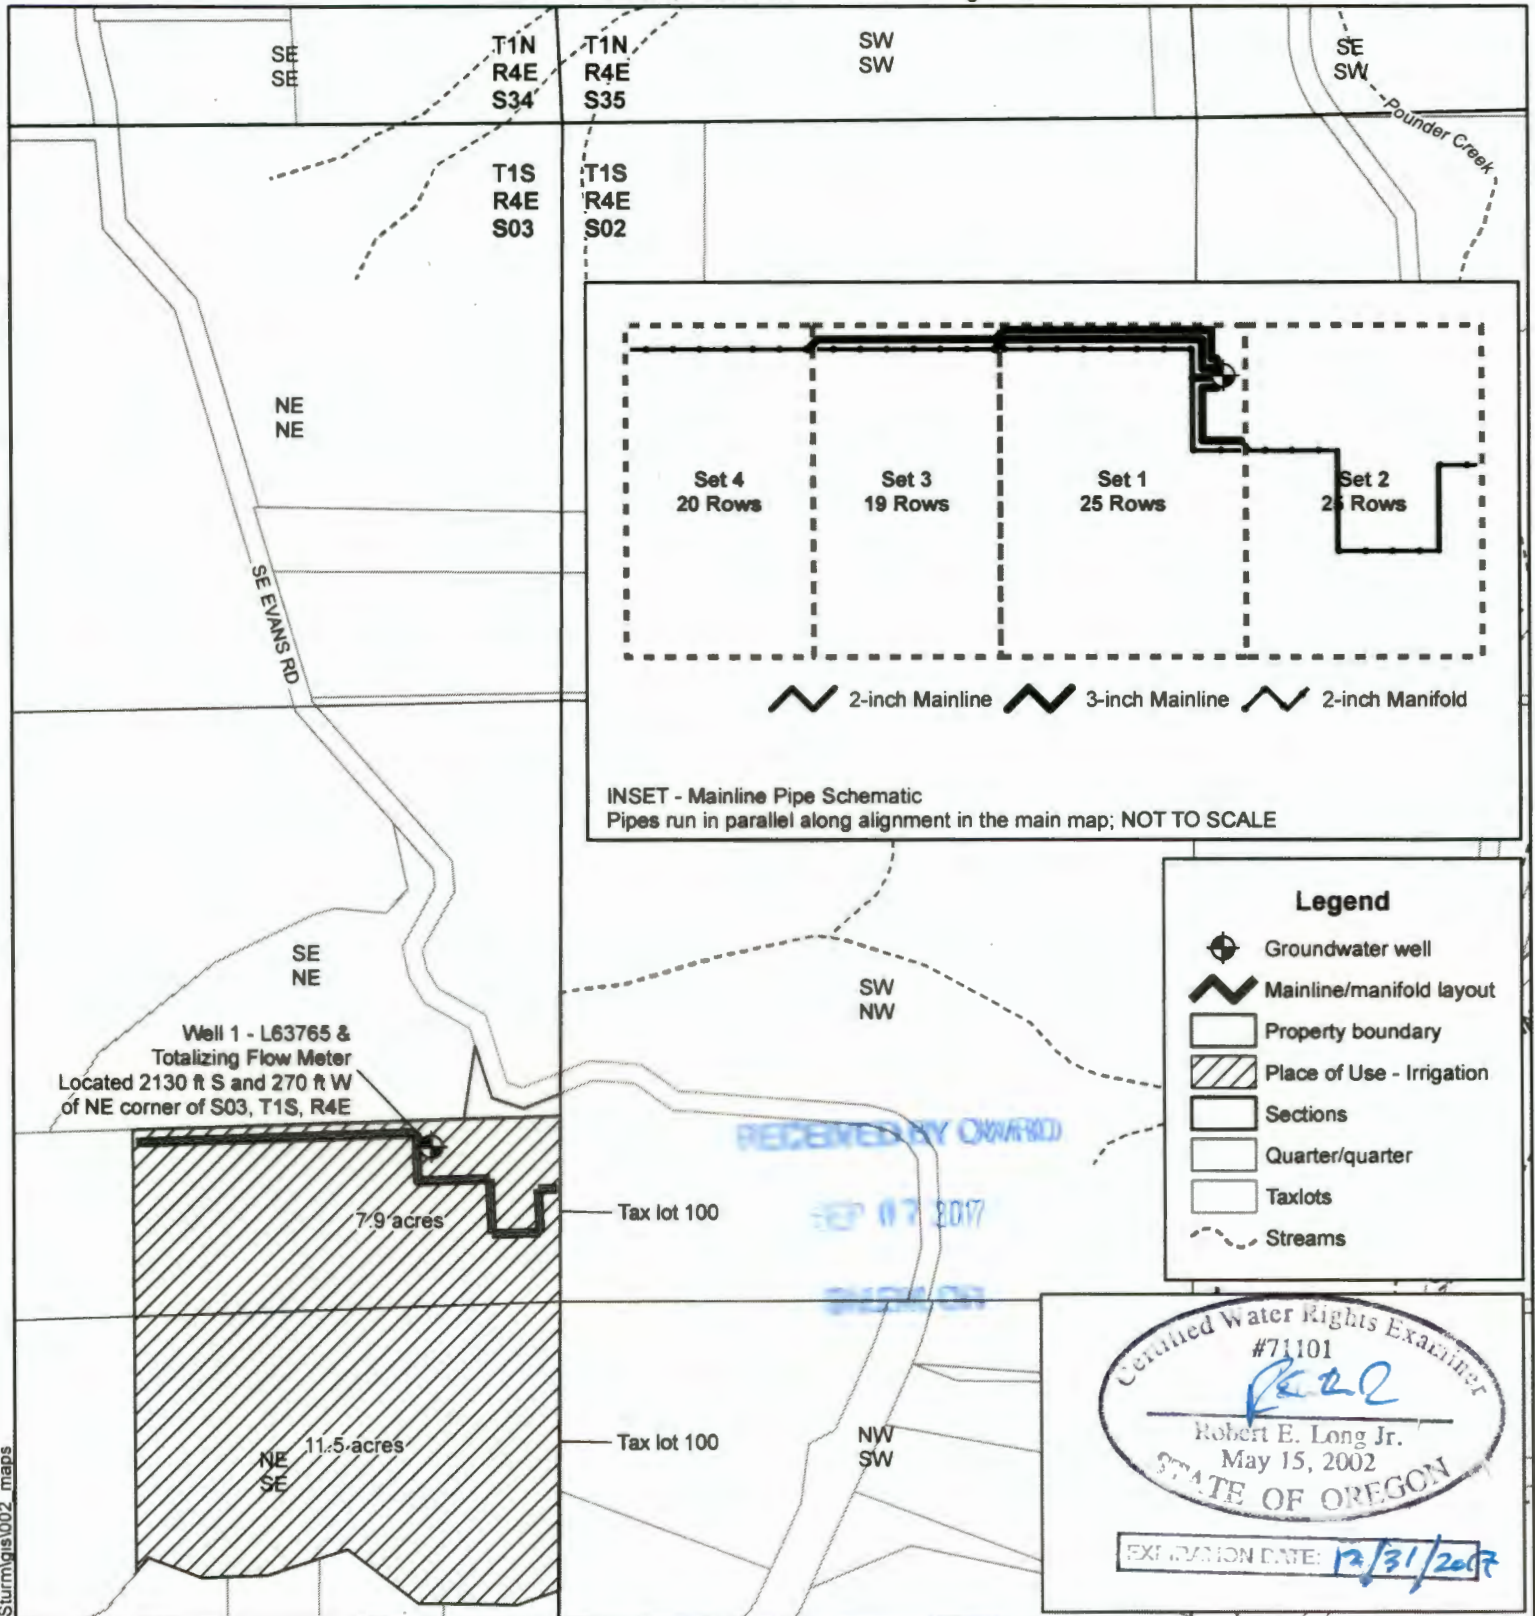

Legend

- Groundwater well
- Mainline/manifold layout
- Property boundary
- Place of Use - Irrigation
- Sections
- Quarter/quarter
- Taxlots
- Streams

CWM-H2O
 Complete Water Management

415 Colony Drive
 Portland, Oregon 97219
 (503) 893-5937

This map is not intended to provide legal dimensions or property ownership lines.

1	02/21/17	RMS	DRAFT
No.	Date	By	Revisions

200 0 200 400 ft
 1 inch = 400 ft

Proj#: 1608001
 Sturm Berry Farm - Evans Road
 Donald Sturm
 PO Box 245
 Corbett, OR 97019

C:\001 CWM Projects\1608001 Sturm\gis\002_maps