


- LEGEND**
- ⊙ Point of Appropriation (POA)
 - ▨ Place of Use (POU)
 - ⊞ Donation Land Claim (DLC)
 - ⊞ Service Area
 - ⊞ All Other Features
 - ⊞ City Boundary
 - ⊞ Tax Lot
 - ⊞ Major Road
 - ⊞ Railroad
 - ⊞ Watercourse
 - ⊞ Waterbody

Claim of Beneficial Use, Transfer T-12046
A Water Right in the Name of City of Aumsville
 Marion County
 Township 8 South, Range 1, 2 West (W.M.)

CERTIFIED WATER RIGHTS EXAMINER STAMP

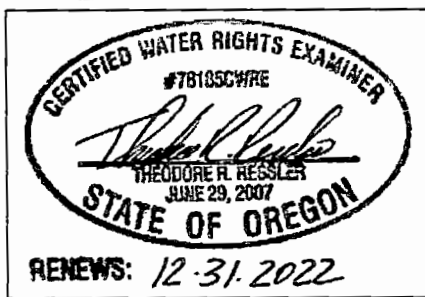


RECEIVED
 JUN 24 2021
 OWRD

DISCLAIMER
 This map was prepared for the purpose of identifying the location of a water right only and it is not intended to provide legal dimensions or location of property ownership lines.

Date: May 14, 2021
 Data Sources: BLM, ESRI, OWRD, USGS

LOCATION DESCRIPTION
 Tower Well (MARI 67874)
 Located 2080 feet South and 1025 feet West from the SE corner of DLC 38, Township 8 South, Range 2 West (W.M.)

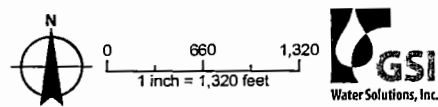

Document Path: Y:\0476 Westech_EI\mxd\map\Source_Figures\009_20_21_WR_Task\COBU_T12046.mxd_abairry