
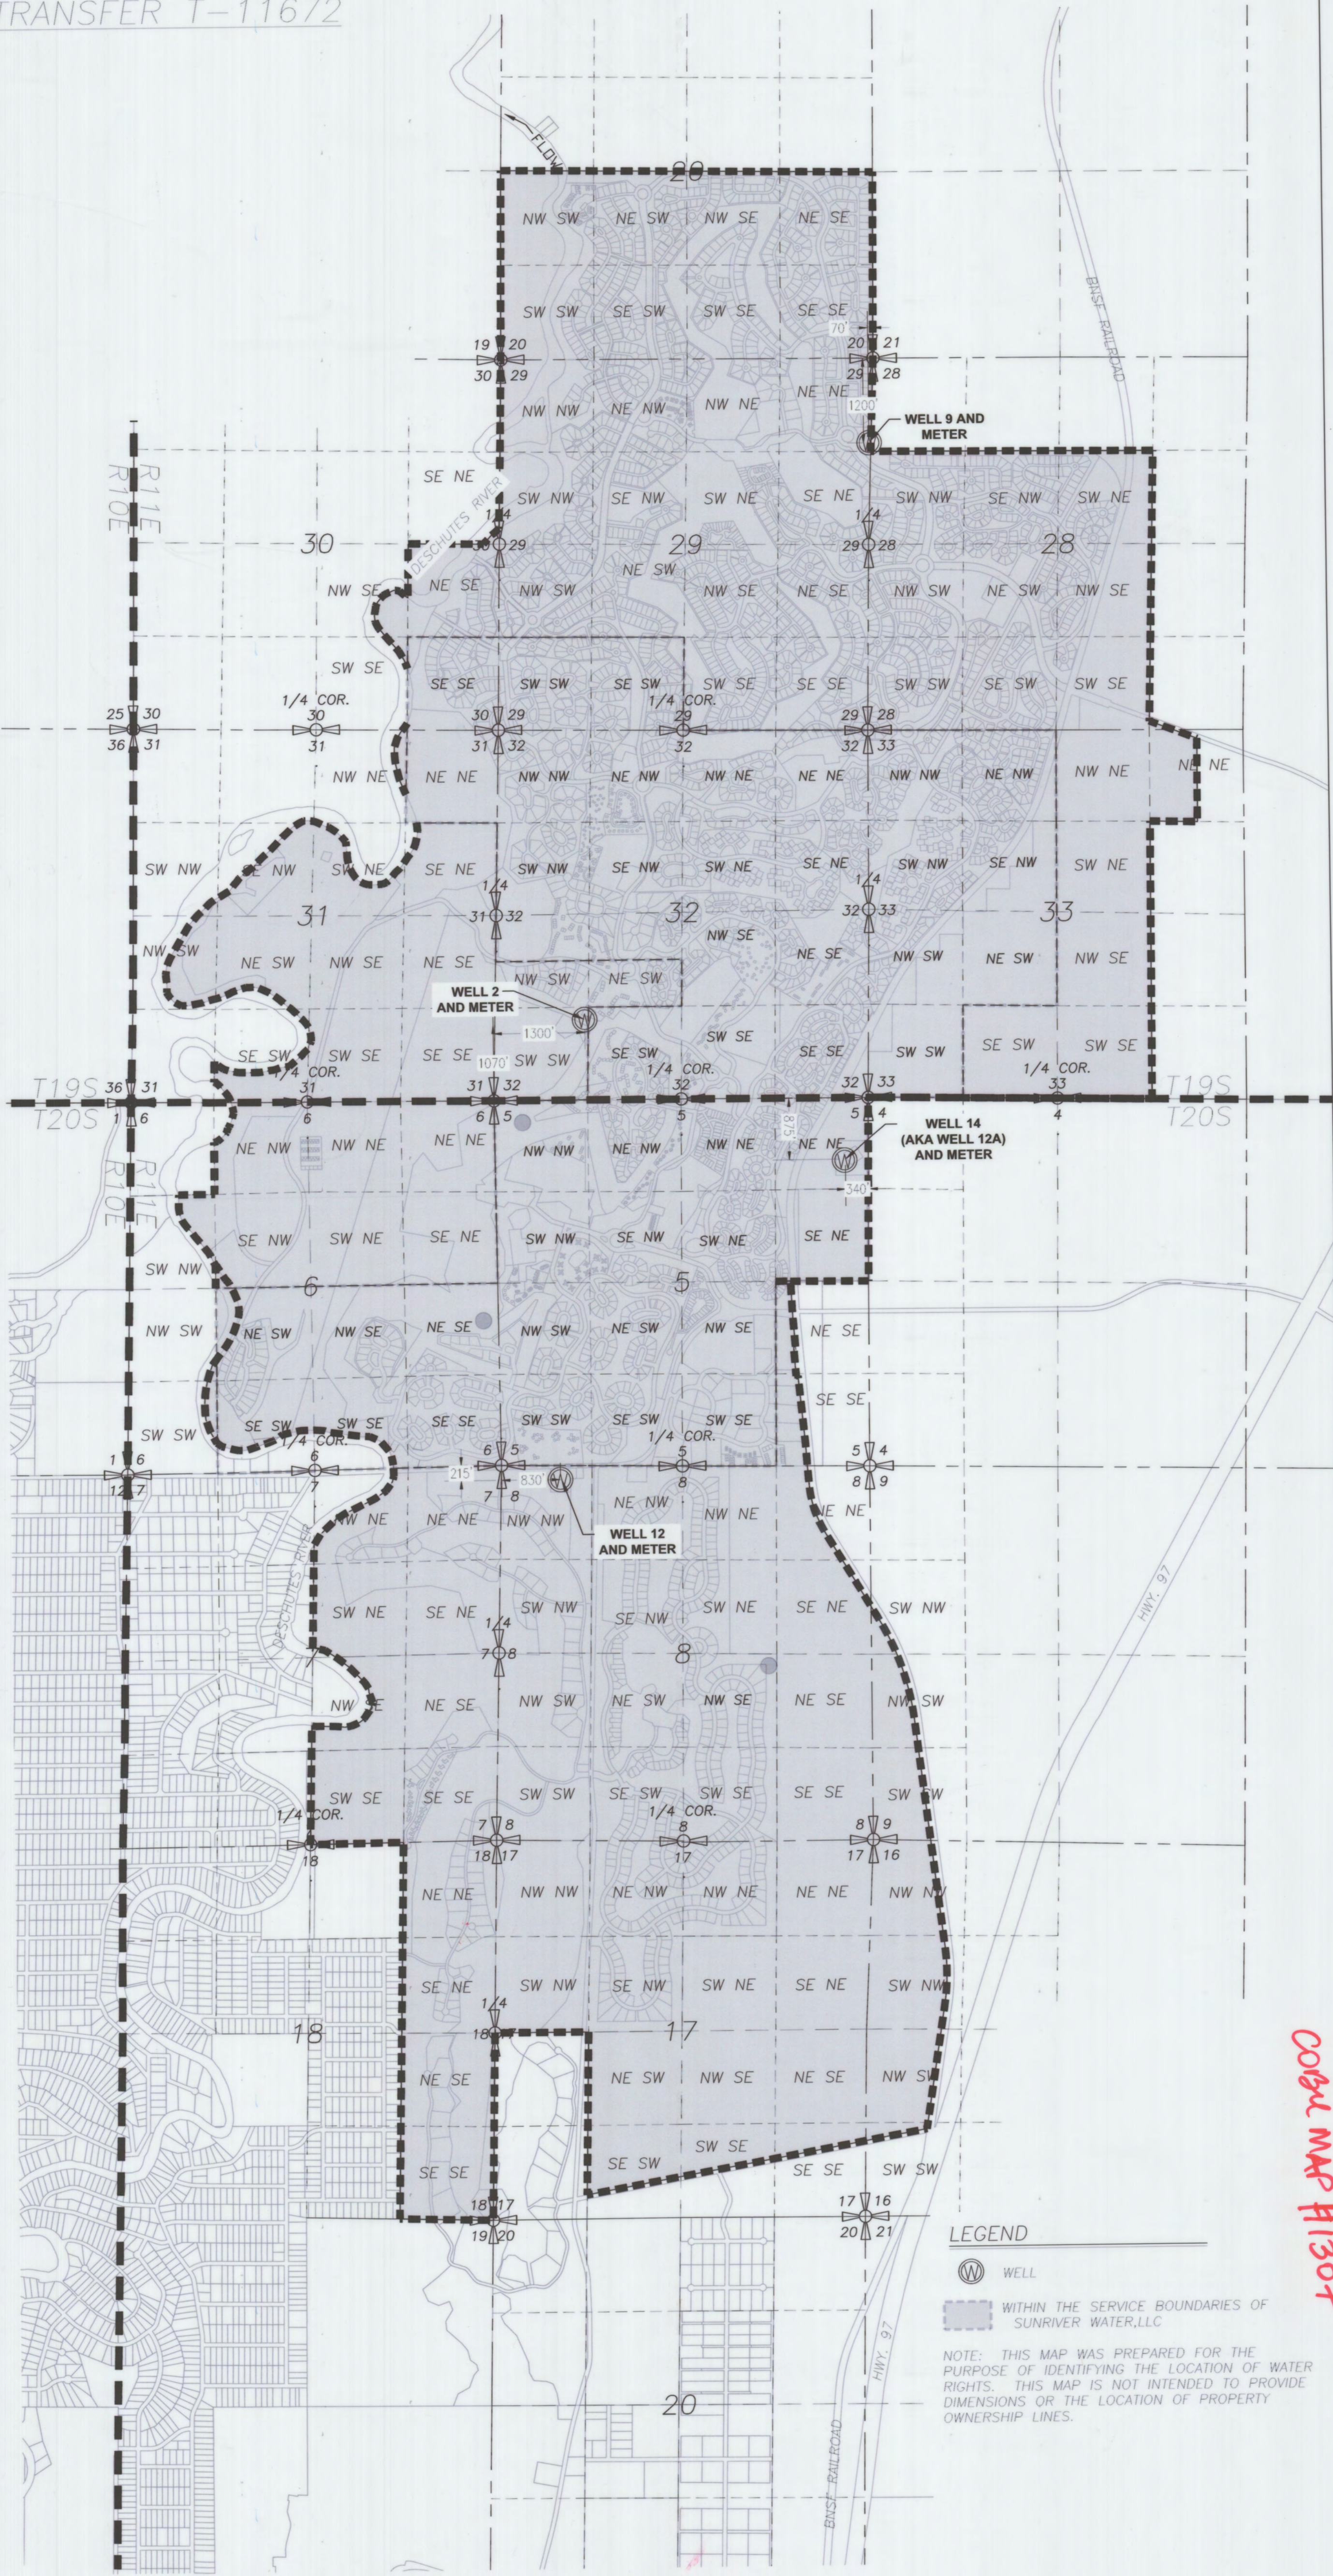


CLAIM OF BENEFICIAL USE FOR TRANSFER T-11672


TYPE OF USE:
QUASI-MUNICIPAL

PRIORITY DATE(S):
AUGUST 28, 1972 FOR 1.1 CFS &
SEPTEMBER 5, 1967 FOR 2.3 CFS

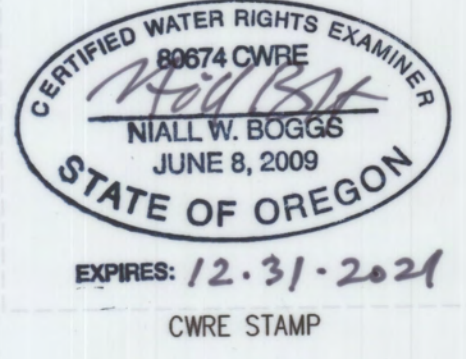

COBU MAP # 1307

COBU MAP #1307

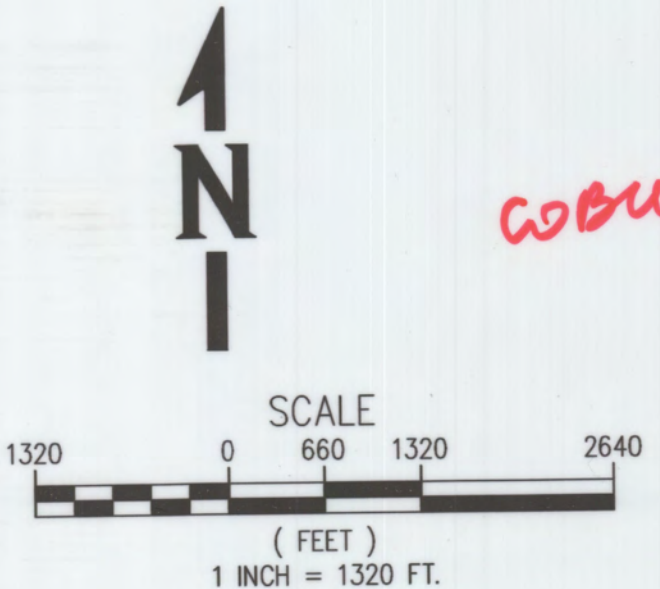

RECEIVED
AUG 16 2021
OWRD