


T4N, R29E, Sec 05
QQ SW SW 1.00 Acres Tax Lot 1401
Partial Cancellation of C.42340

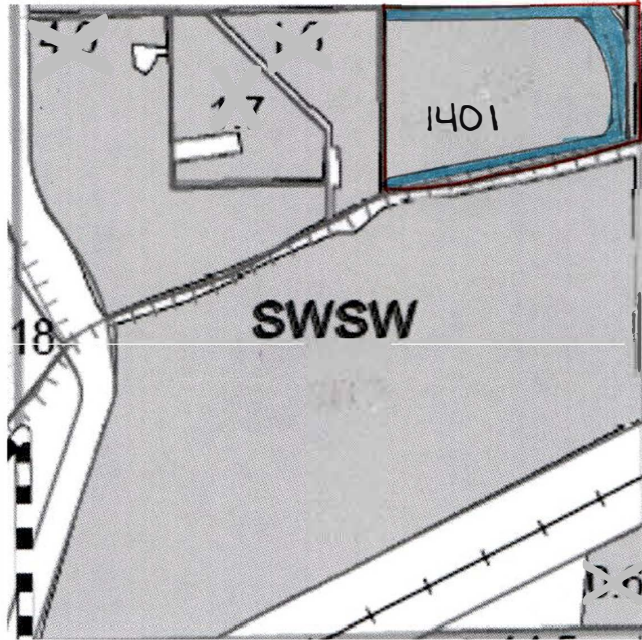

	partial cancellation of Certificate 42340 - 1.0 acre for Zabransky
	Property Line


1 Inch = 400 Feet

2021 Hermiston Irrigation District
Permanent Transfer T-13646

13646 -

G-4854
42340

T.4N. R.29E. W.M.

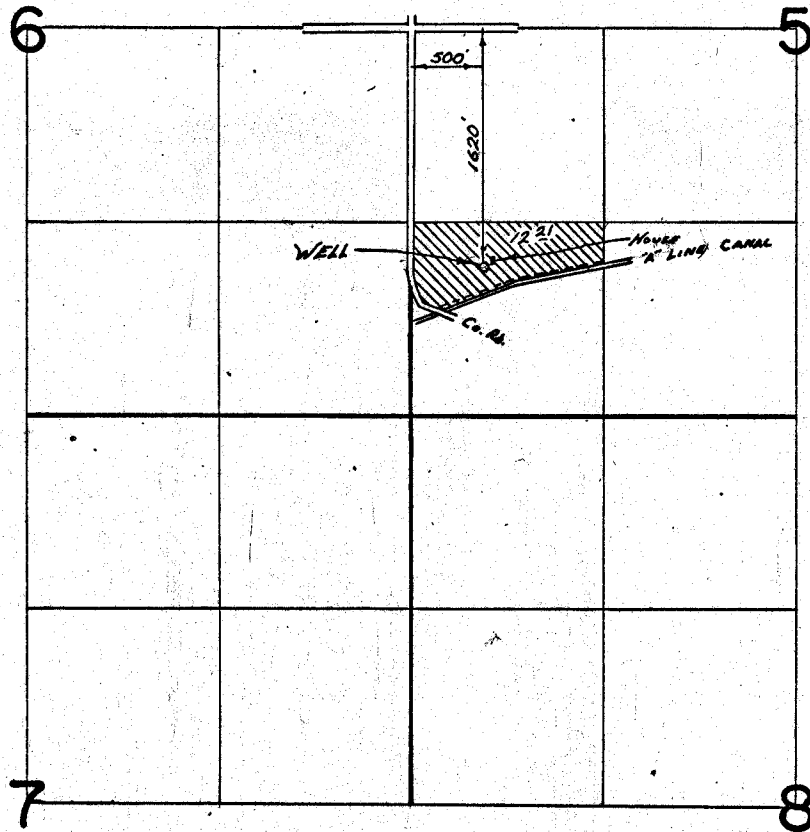

FINAL PROOF SURVEY
UNDER

Application No. G-5115... Permit No. G-4854.
IN NAME OF

EARL E. & MAOLA R. BALDWIN

Surveyed APRIL 16 1974, by THOMAS J. PAUL