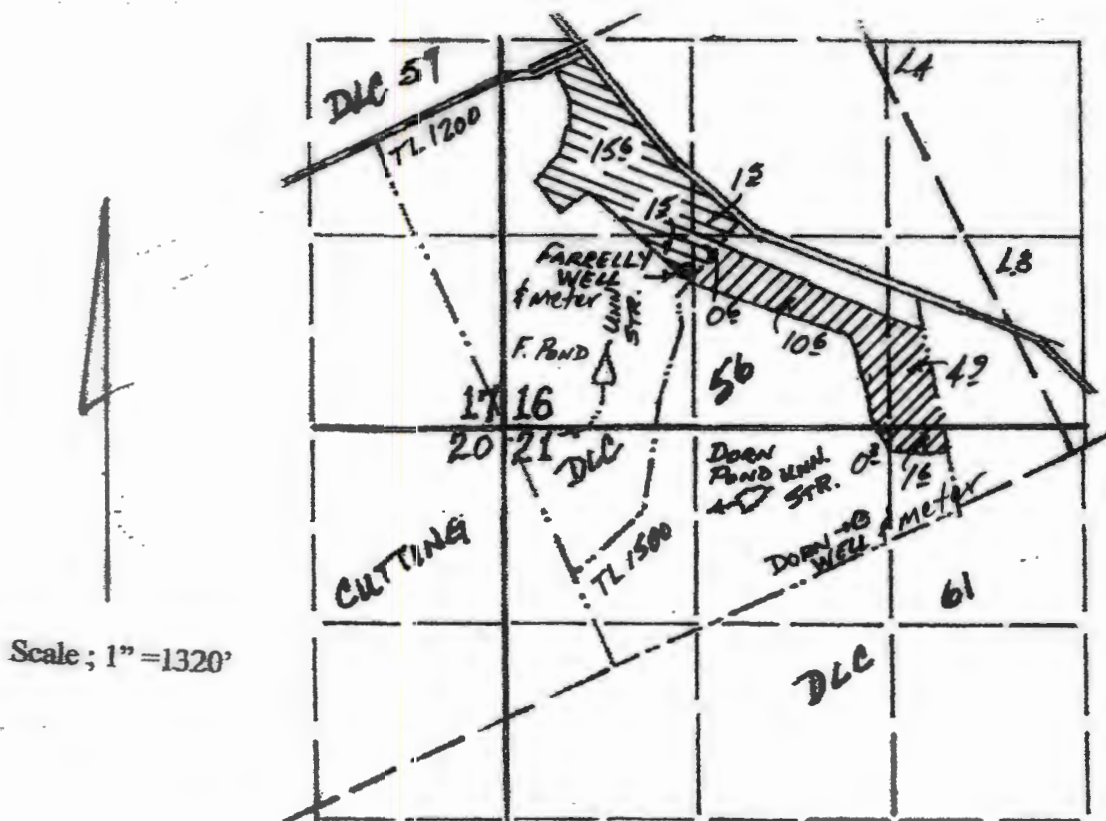


JUL 12 2016

WATER RESOURCES DEPT
SALEM, OREGON

T.3 S., R.3 E., WM
Sections 16 & 21

 Farely Permit G-16460 Dorn Permit G-16459

**POD's Located: Farrelly Pond – 440' N & 3170' W;
Farrelly Well – 1240' N & 2600' W;
Dorn Pond – 370' S & 2240' W;
Dorn Well-460' S & 1240' W; all from the SE Corner Cutting DLC 56.**

This map is for the purpose of identifying the location of water rights only, and is not intended to provide legal dimensions or locations of property lines.