


FINAL PROOF MAP

TO ADD PLACE OF USE &
POINTS OF APPROPRIATION
FOR PERMIT G-16883

TAX LOT: 2200 IN SECTION 33,
TOWNSHIP 21 SOUTH, RANGE 20 EAST, W.M.


RECEIVED
MAY 10 2018

OWRD

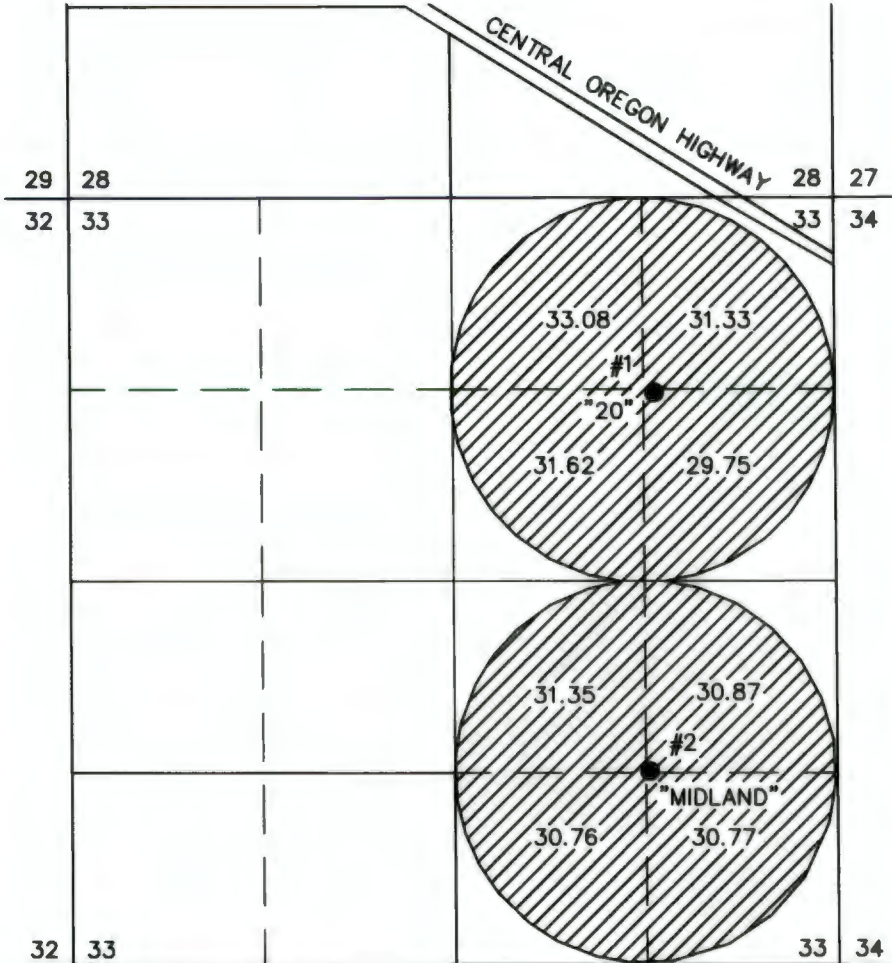

- WELL 1 (DESC59429) "20"**
● LOCATED IN THE SE 1/4 NE 1/4 SECTION 33, T21S R20E, W.M. AND 3950 FEET NORTH AND 1271 FEET WEST FROM THE SE CORNER OF SECTION 33. FLOW METER IS LOCATED 14 FEET NORTH OF WELL.
- WELL 2 (DESC59430) "MIDLAND"**
● LOCATED IN THE NE 1/4 SE 1/4 SECTION 33, T21S R20E, W.M. AND 1337 FEET NORTH AND 1310 FEET WEST FROM THE SE CORNER OF SECTION 33. FLOW METER IS LOCATED 11 FEET WEST OF WELL.

T 22S, R 20E, W.M.

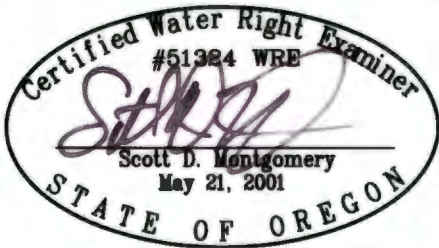

RENEWAL DATE: 12/31/2018



249.53 ACRES 'R' RIGHTS FROM WELLS 1 & 2 PER G-16883, AS SHOWN.

THIS MAP IS FOR THE PURPOSE OF LOCATING A WATER RIGHT ONLY AND HAS NO INTENT TO PROVIDE LEGAL DIMENSIONS OR THE LOCATION OF PROPERTY LINES.

<p>PREPARED FOR:</p> <p>OREGON DEPT. OF STATE LANDS 775 SUMMER ST. NE #100 SALEM, OR 97301</p>	<p>PREPARED BY:</p> <p>ALL POINTS ENGINEERING AND SURVEYING, INC. P.O. BOX 767 TERREBONNE, OR 97760 (541) 548-5833 www.APEandS.com</p>
--	--