

RECEIVED BY OWRD


JAN 13 2017

SALEM, OR


CLAIM OF BENEFICIAL USE MAP
FOR
STEVE ALLEN
TAX LOTS 1800, 1900, AND 3801
MAP T10S, R11W, W.M., SEC17
NOVEMBER 15, 2016

EXHIBIT A

APPLICATION S-86603
PERMIT S-54366

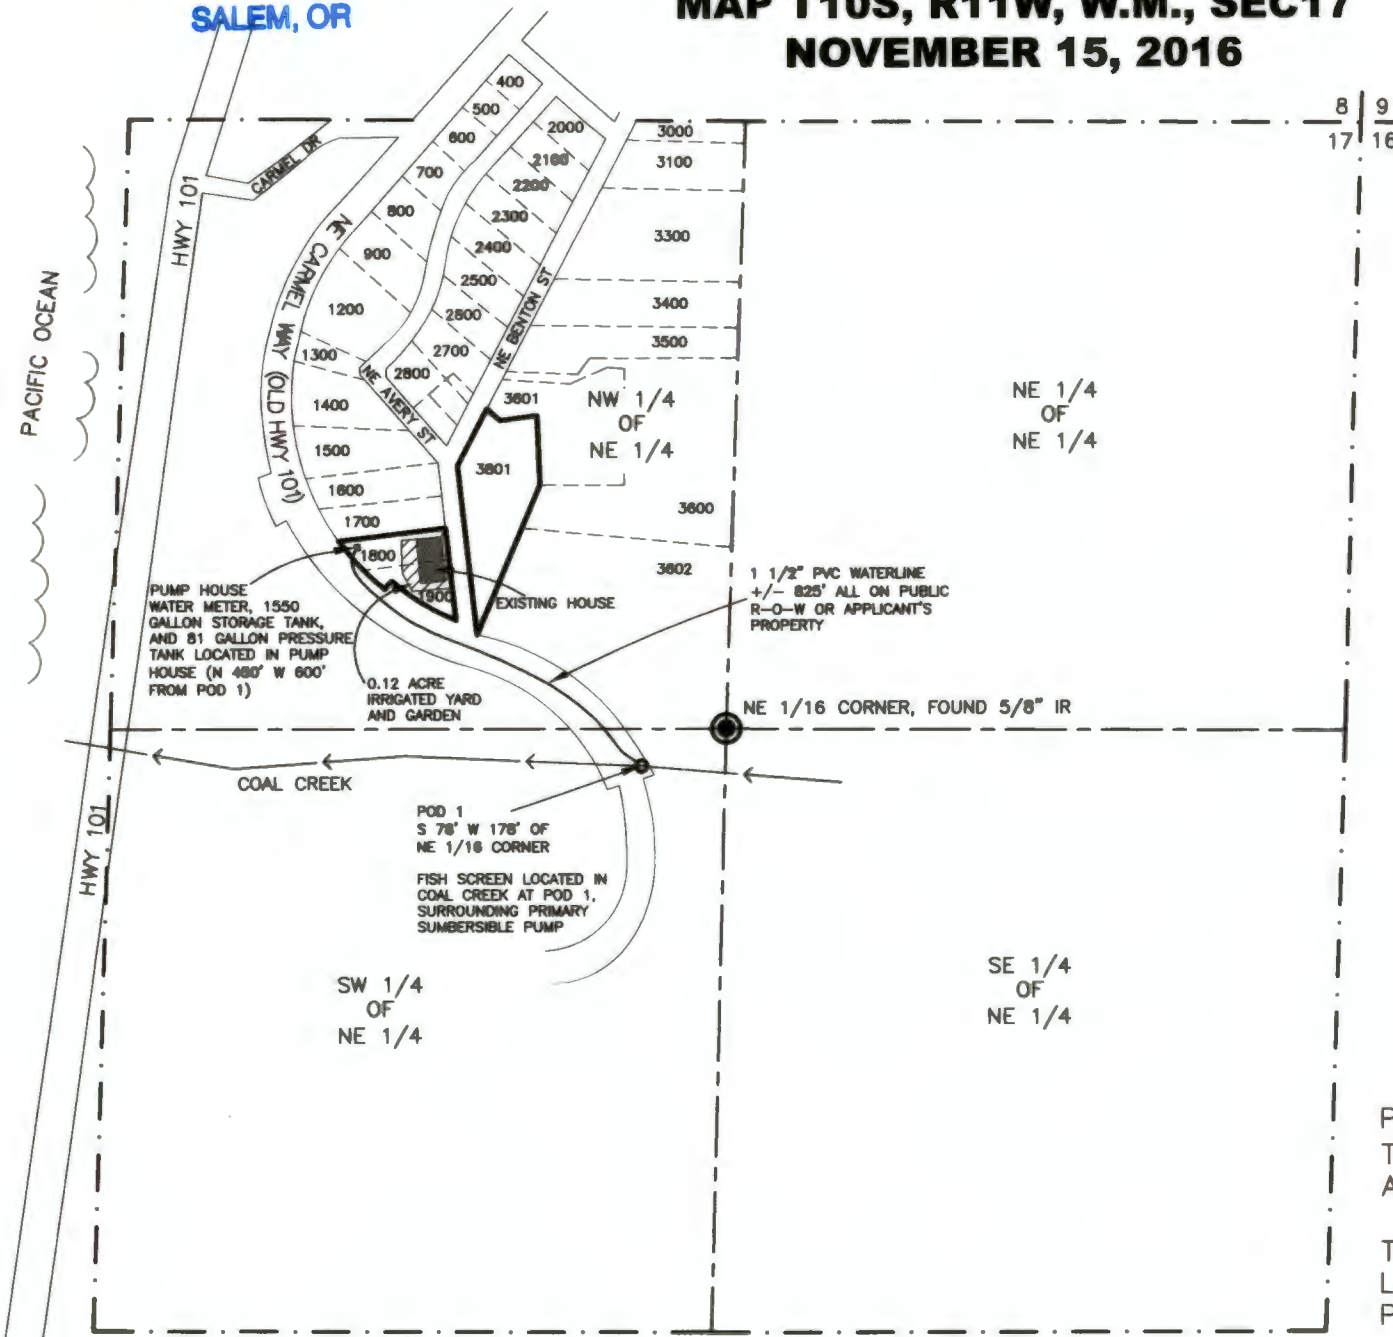

SCALE 1" = 400'

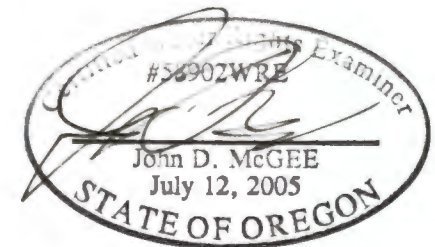

RENEWAL DATE: 12/31/2018

LEGEND

- QTR SECTION LINE
- QTR-QTR LINES
- TAXLOT LINES
- ROAD LINES
- ← CREEK
- PERMIT HOLDER'S PROPERTY LINES

POSITIONS OF STRUCTURES RELATIVE TO THE NE 1/16 CORNER ARE BASED ON A CONVENTIONAL TRAVERSE SURVEY

THIS MAP IS NOT INTENDED TO PROVIDE LEGAL DIMENSIONS OR LOCATIONS OF PROPERTY OWNERSHIP LINES.