



T10S, R39E, Section 15, Willamette Meridian

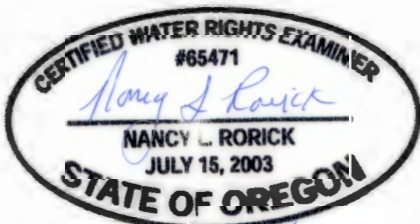

Expires 12/31/2018

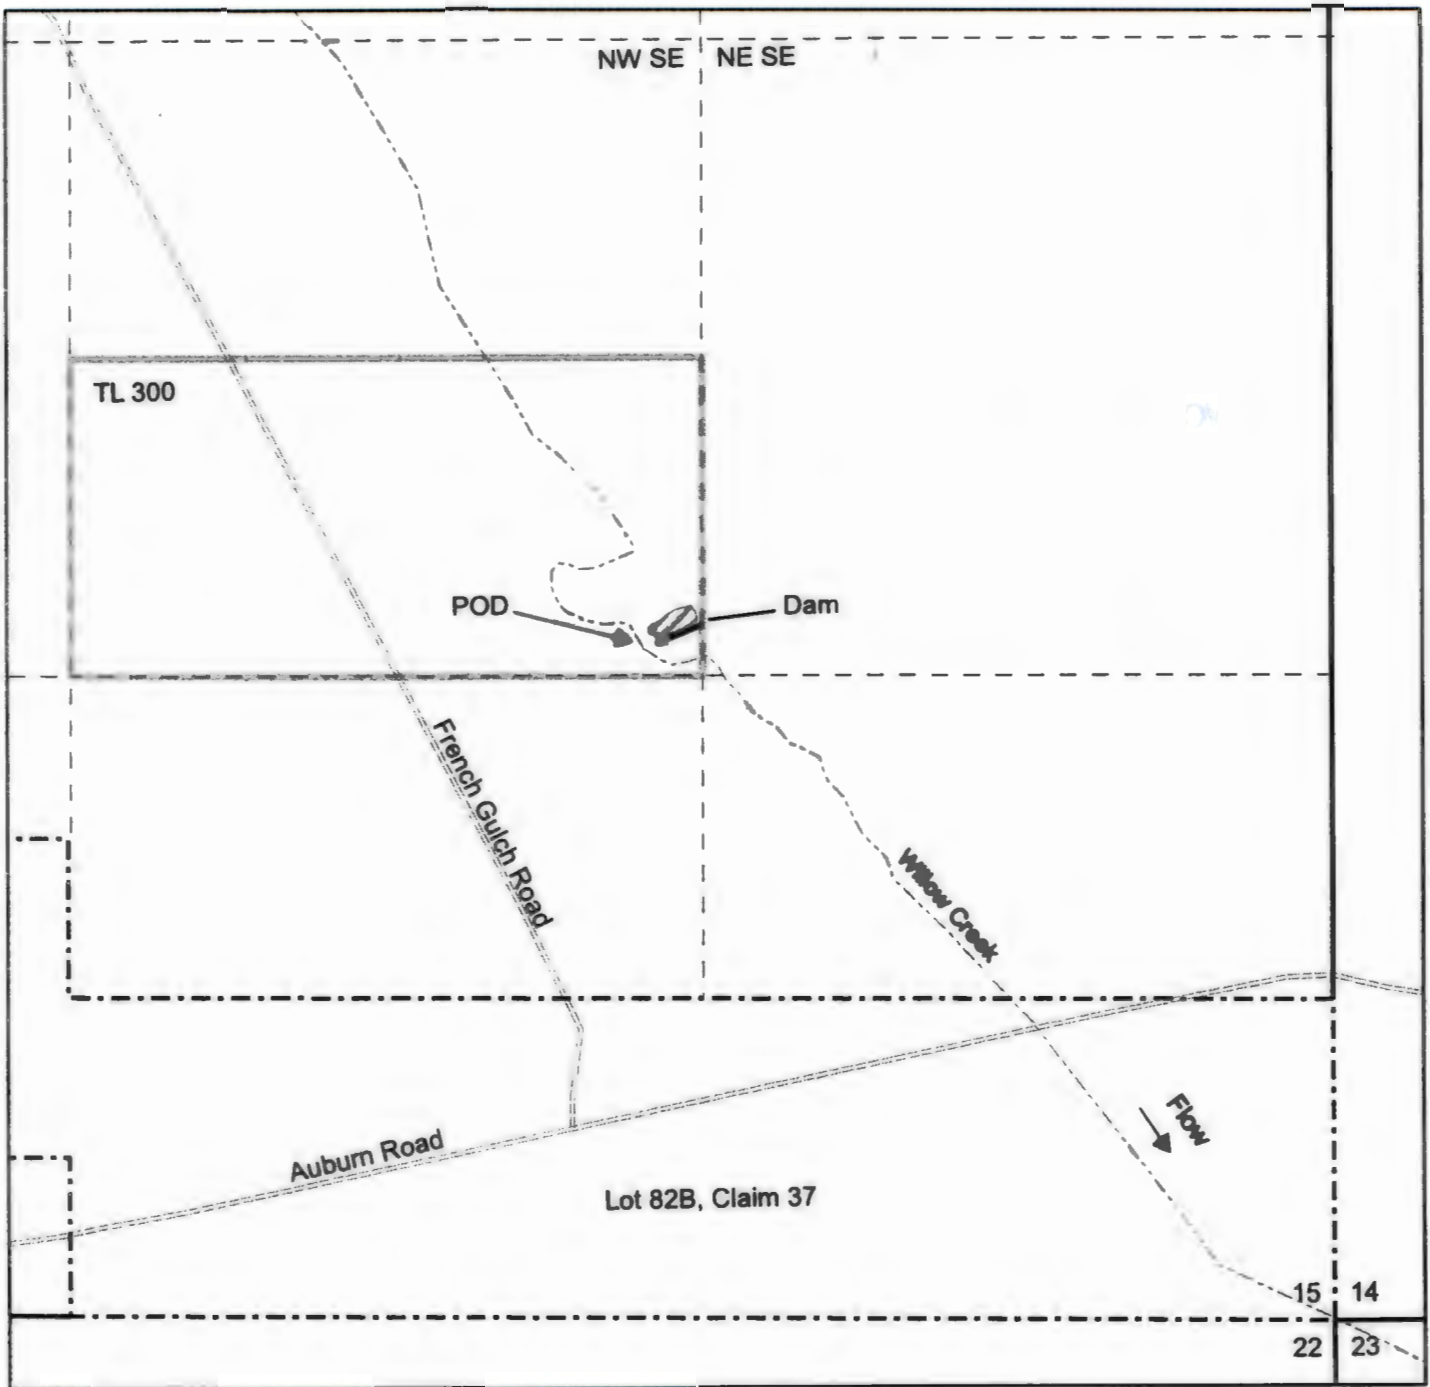

0 200 400
Feet

1 inch = 400 feet

- ===== Unpaved road
- Intermittent stream
- - - - Mineral survey
- - - - Quarter quarter line
- Section line
- Tax lot
-  Reservoir Permit R14337

The dam is located 1435 feet north and 1400 west of the SE corner of section 15, T10S, R39E.

This map is not intended to provide legal dimensions or locations of property ownership lines.

Final Proof Map
Patrick Maahs
Tax Lot 300
Reservoir permit R14337