



**T23S R33E, WM**  
**HARNEY COUNTY, OREGON**



- ..... Pipeline
- Well
- Meter
- POU IR
- Township
- Section
- ..... Quarter Quarter
- Taxlot

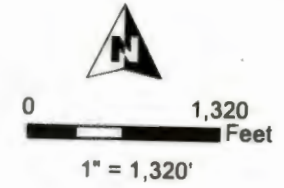

RENEWAL DATE 12/31/2019

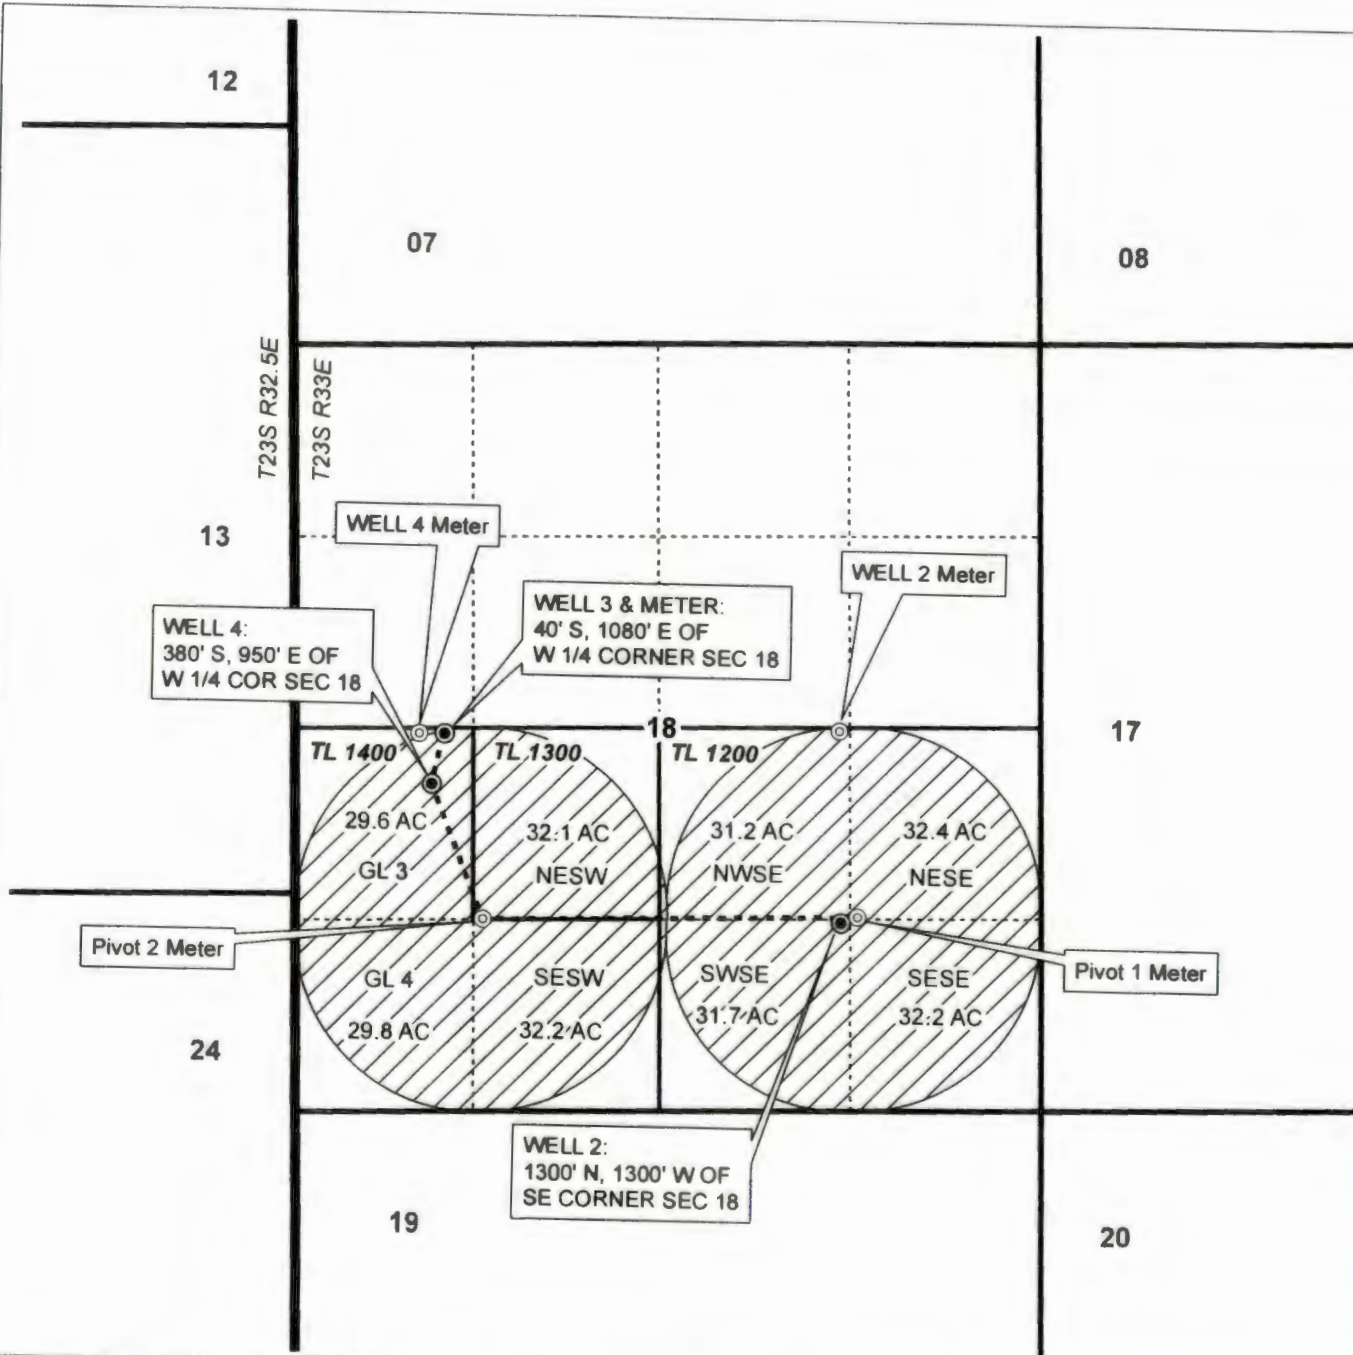

**CLAIM OF BENEFICIAL USE MAP**  
**John Ensz Farms, LLC**

NOTE: THIS MAP IS NOT INTENDED TO  
 PROVIDE LEGAL DIMENSIONS OR LOCATIONS  
 OF PROPERTY OWNERSHIP LINES.

**WATER RIGHT SERVICES, LLC**  
 PO BOX 1830, BEND, OR 97709  
 CCB# 197121 [www.oregonwater.us](http://www.oregonwater.us)  
 541-389-2837 [JOHNSHORT@USA.COM](mailto:JOHNSHORT@USA.COM)

AP G-17061/T-12317

PERMIT G-17672

PROJECT #19017

Date: 6/26/2019