



Rec'd 10-1-2021 via email

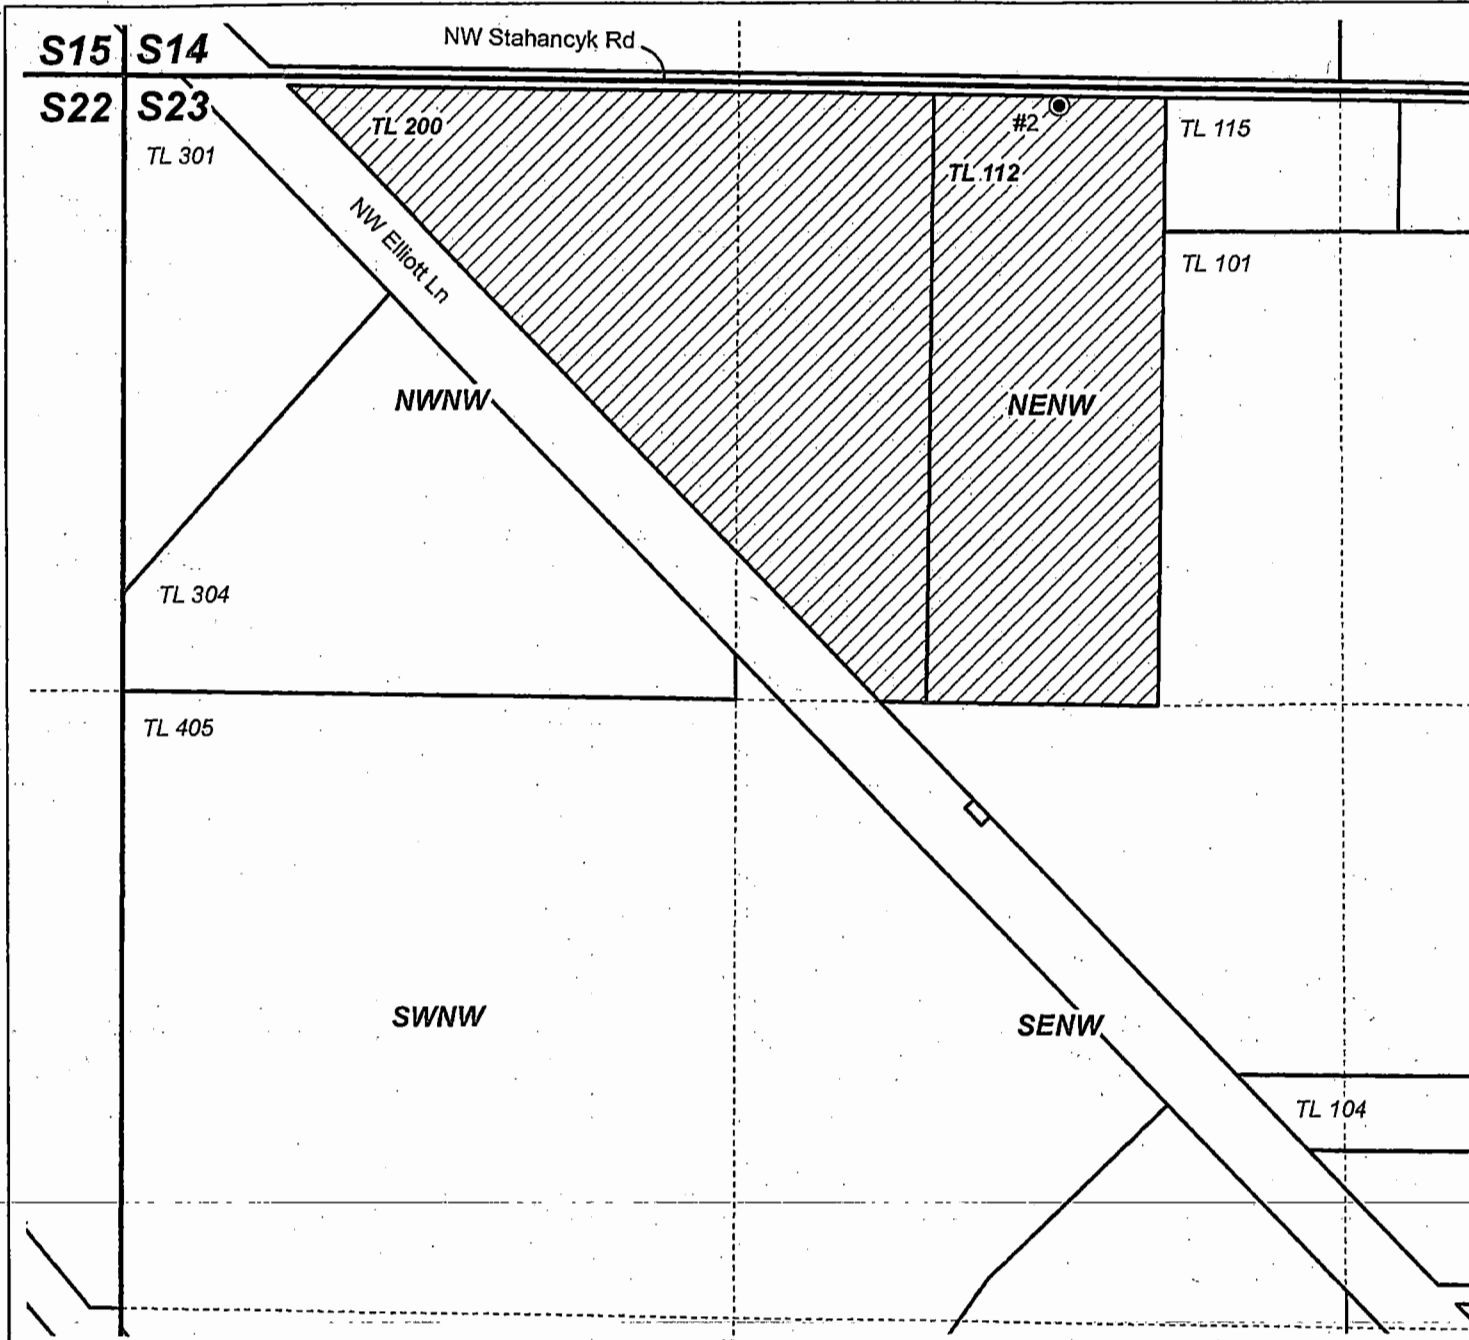

T14S R15E, WM,
CROOK COUNTY, OR

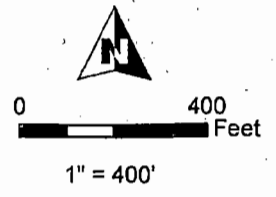

- ⊙ Well & Meter
- POU Industrial Use
- Section
- - - Quarter Quarter
- Tax Lot

WELL LOCATION:

Well #2 (CROO 50577 / L-20397):
40' S, 600' W of N 1/4 Cor Sec 23



RENEWAL DATE 12/31/2022



**CLAIM OF BENEFICIAL USE MAP
STAFFORD RANCHES**

Ap G-14725 Permit G-18475 Date: 9/30/2021.

This map is not intended to provide legal dimensions or locations of property ownership lines.

WATER RIGHT SERVICES, LLC
PO BOX 1830, BEND, OR 97709
WWW.OREGONWATER.US CCB # 197121
johnshort@usa.com 541-389-2837