


# T18S R2W & T18S R1W, WM, LANE COUNTY, OR

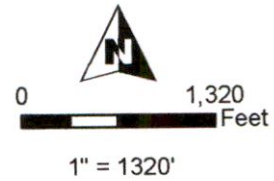


- ⊙ Proposed POD
- Authorized POD
- Streams
- C-19509 IR (NOT AFFECTED)
- C-19509 IR PROPOSED FOR NEW POD
- C-30982 IR (PROPOSED FOR NEW POD)
- C-30981 Storage & Fish (PROPOSED FOR NEW POD)
- Township
- Section
- Quarter Quarter
- DLC
- Tax Lot

Proposed POD Location:

120' N, 780' E of W 1/4 Cor Sec 31, T18S R1W, W.M.

RECEIVED  
FEB 1-8 2021  
OWRD

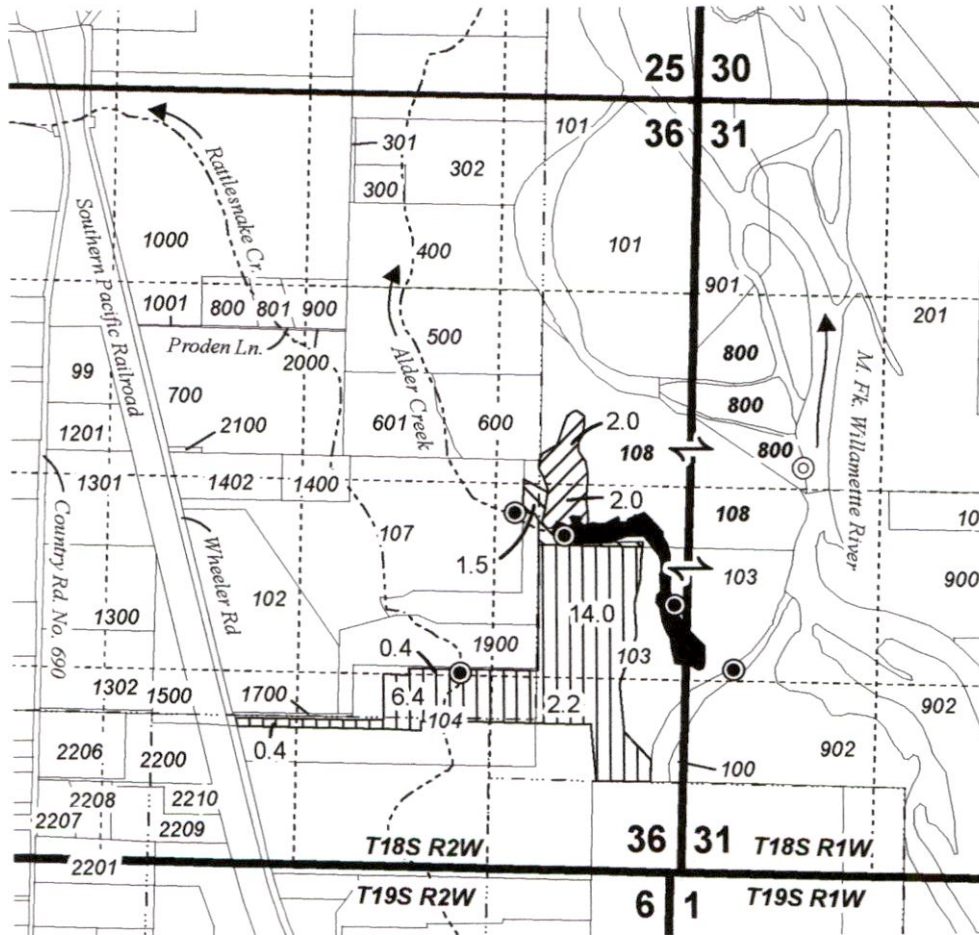

13637 -

C-19509, C-30981, & C-30982

**POD CHANGE CAUSED  
BY GOVERNMENT ACTION MAP**  
Tim Willett Date: 2/4/2021

This map is not intended to provide legal dimensions or locations of property ownership lines.

**WATER RIGHT SERVICES, LLC**  
PO BOX 1830, BEND, OR 97709  
WWW.OREGONWATER.US CCB # 197121  
johnshort@usa.com 541-389-2837