


T.14S. R.15E. Section 36, W.M.

1. TL 14S15E36AC 0100 (Space 20)
2. TL 14S15E36AC 0200 (Space 19)
3. TL 14S15E36AC 0300 (Space 18)
4. TL 14S15E36AC 0400 (Space 17)
5. TL 14S15E36AC 0500 (Space 16)
6. TL 14S15E36AC 0600 (Space 15)
7. TL 14S15E36AC 0700 (Space 14)
8. TL 14S15E36AC 0800 (Space 13)
9. TL 14S15E36AC 1000 (Space 12)
10. TL 14S15E36AC 1200 (Space 11)
11. TL 14S15E36AC 1300 (Space 10)
12. TL 14S15E36AC 1400 (Space 9)
13. TL 14S15E36AC 1500 (Space 8)
14. TL 14S15E36AC 1600 (Space 7)
15. TL 14S15E36AC 1700 (Space 6)
16. TL 14S15E36AC 1800 (Space 5)
17. TL 14S15E36AC 1900 (Space 4)
18. TL 14S15E36AC 2000 (Space 3)
19. TL 14S15E36AC 2100 (Space 2)
20. TL 14S15E36AC 2200 (Space 1)
21. TL 14S15E36AC 2300 (Space 21)

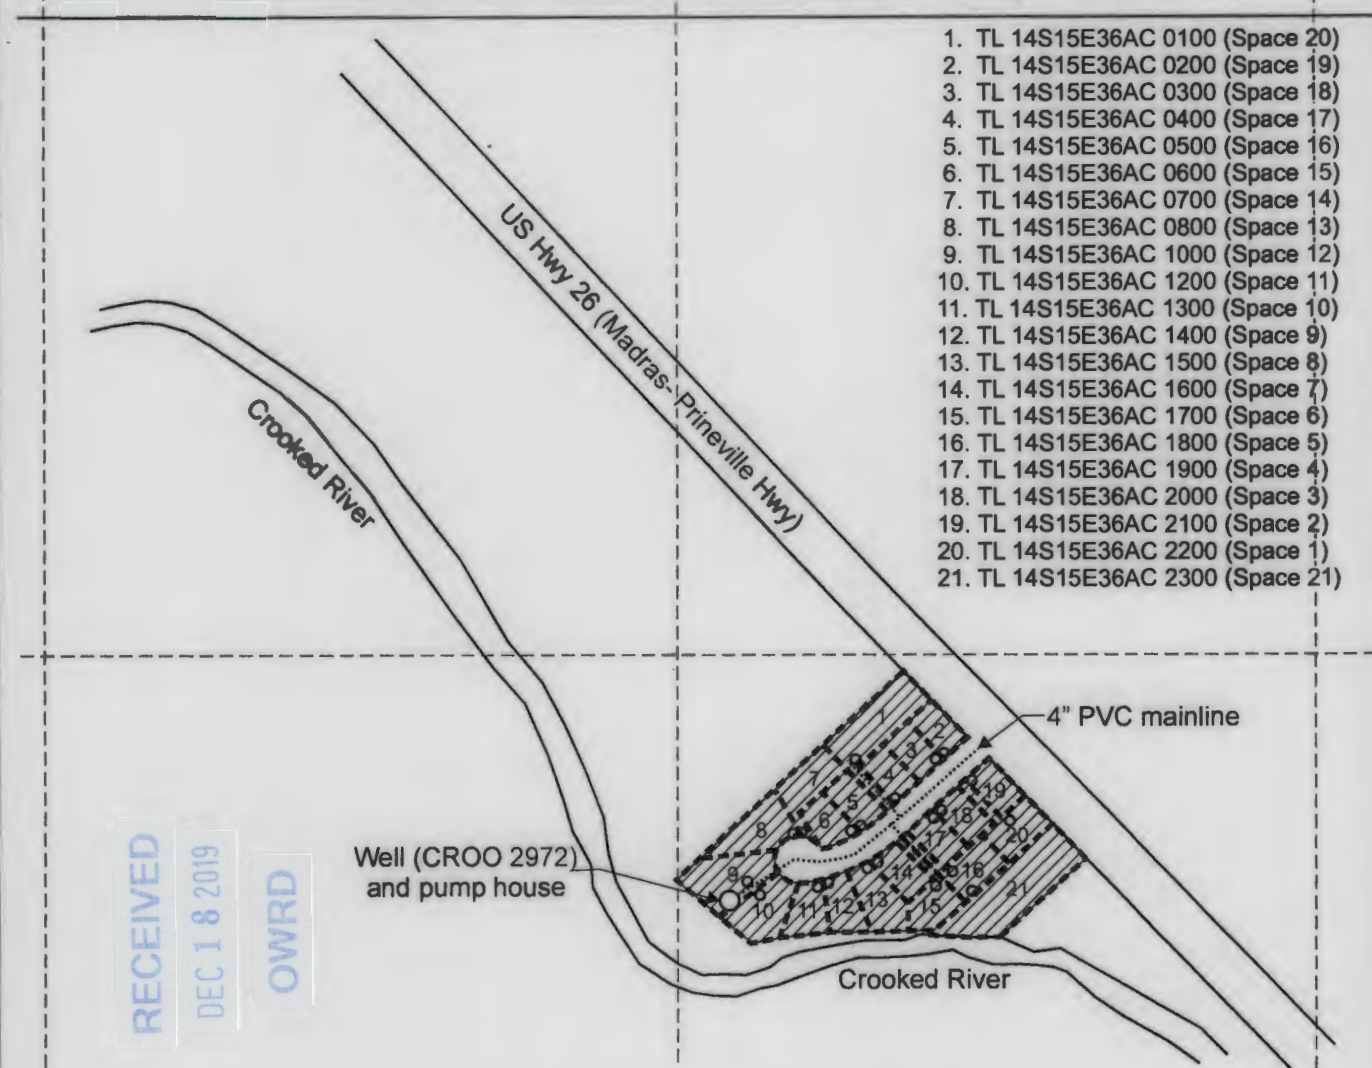

RECEIVED
 DEC 18 2019
OWRD

Well (CROO 2972) and pump house

4" PVC mainline

Crooked River

Well (CROO 2972) is located 1,828 feet south and 108 feet east from the N 1/4 corner of Section 36.

Area (21 Sites) covered by Quasi-municipal under T-12781.

Tax lot boundary


Mainline

Meter locations

36



Scale: 1" = 400'

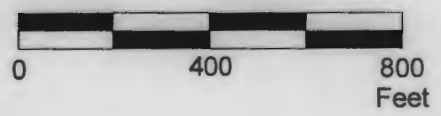

This map was prepared for the purpose of identifying the location of a water right only and is not intended to provide legal dimensions or location of property ownership lines.

**Claim of Beneficial Use Map
T-12781**

McDougal Water System
T.14S. R.15E. Section 36, W.M.

Pacific Hydro-Geology Inc.

12/2019

McDougalT-12781COBUr.cdr