


Document Path: Y:\0576 Roseburg Forest Products\Source Figures\002_2020_WR_Svcs\COBU_Transfer\12596_Spiller\23974.mxd_hpalmr

LEGEND

- Point of Diversion (POD)
- Staff Gage
- Place of Use (POU)
- Tax Lot
- Government Lot (GL)
- Donation Land Claim (DLC)
- Watercourse
- Waterbody

Claim of Beneficial Use
Transfer T-12596 (former Certificate 23974)
 A Water Right in the Name of Roseburg Forest Products
 Douglas County, Oregon
 Township 27 South, Range 4 West (W.M.)

CERTIFIED WATER RIGHTS EXAMINER STAMP

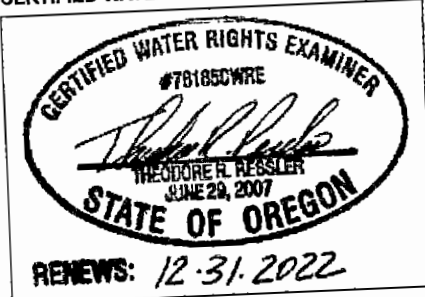

RECEIVED

SEP 22 2021

OWRD

LOCATION DESCRIPTION

Spillway
 Located 190 feet South and 2,340 feet West from the NE corner of Section 19, Township 27 South, Range 4 West (W.M.)

DISCLAIMER
 This map was prepared for the purpose of identifying the location of a water right only and it is not intended to provide legal dimensions or location of property ownership lines.

Date: August 20, 2021
 Data Sources: BLM, ESRI, OWRD, USGS, Douglas Co.

