


Document Path: Y:\0576 Roseburg Forest Products\Source Figures\002_2020_WR_SwestCOBU_Transfer1219\Forms\33596.mxd_npalmat

- LEGEND**
- Point of Diversion (POD)
 - Staff Gage
 - Place of Use (POU)
 - Tax Lot
 - Government Lot (GL)
 - Donation Land Claim (DLC)
 - Watercourse
 - Waterbody

Claim of Beneficial Use
Transfer T-12596 (former Certificate 33596)
 A Water Right in the Name of Roseburg Forest Products
 Douglas County, Oregon
 Township 27 South, Range 4 West (W.M.)

CERTIFIED WATER RIGHTS EXAMINER STAMP

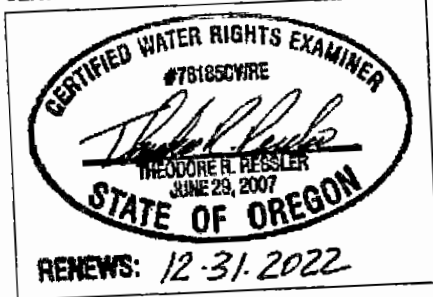

RECEIVED
 SEP 22 2021

OWRD

DISCLAIMER
 This map was prepared for the purpose of identifying the location of a water right only and it is not intended to provide legal dimensions or location of property ownership lines.

Date: August 20, 2021
 Data Sources: BLM, ESRI, OWRD, USGS, Douglas Co.

LOCATION DESCRIPTION
 North Fork Deer Creek POD
 Located 140 feet South and 2,500 feet West from the NW corner of
 DLC 45, Township 27 South, Range 4 West (W.M.)

