


CLAIM OF BENEFICIAL USE MAP

TO ADD POINTS OF APPROPRIATION
FOR APPLICATION T-12864

WHITBY BROTHERS LAND & LIVESTOCK, LLC

SECTIONS 3, 4, 8, 9, & 10, TOWNSHIP 33 SOUTH, RANGE 31 EAST, W.M.
TAX LOT: 1100

SCALE: 4 INCHES = 1 MILE

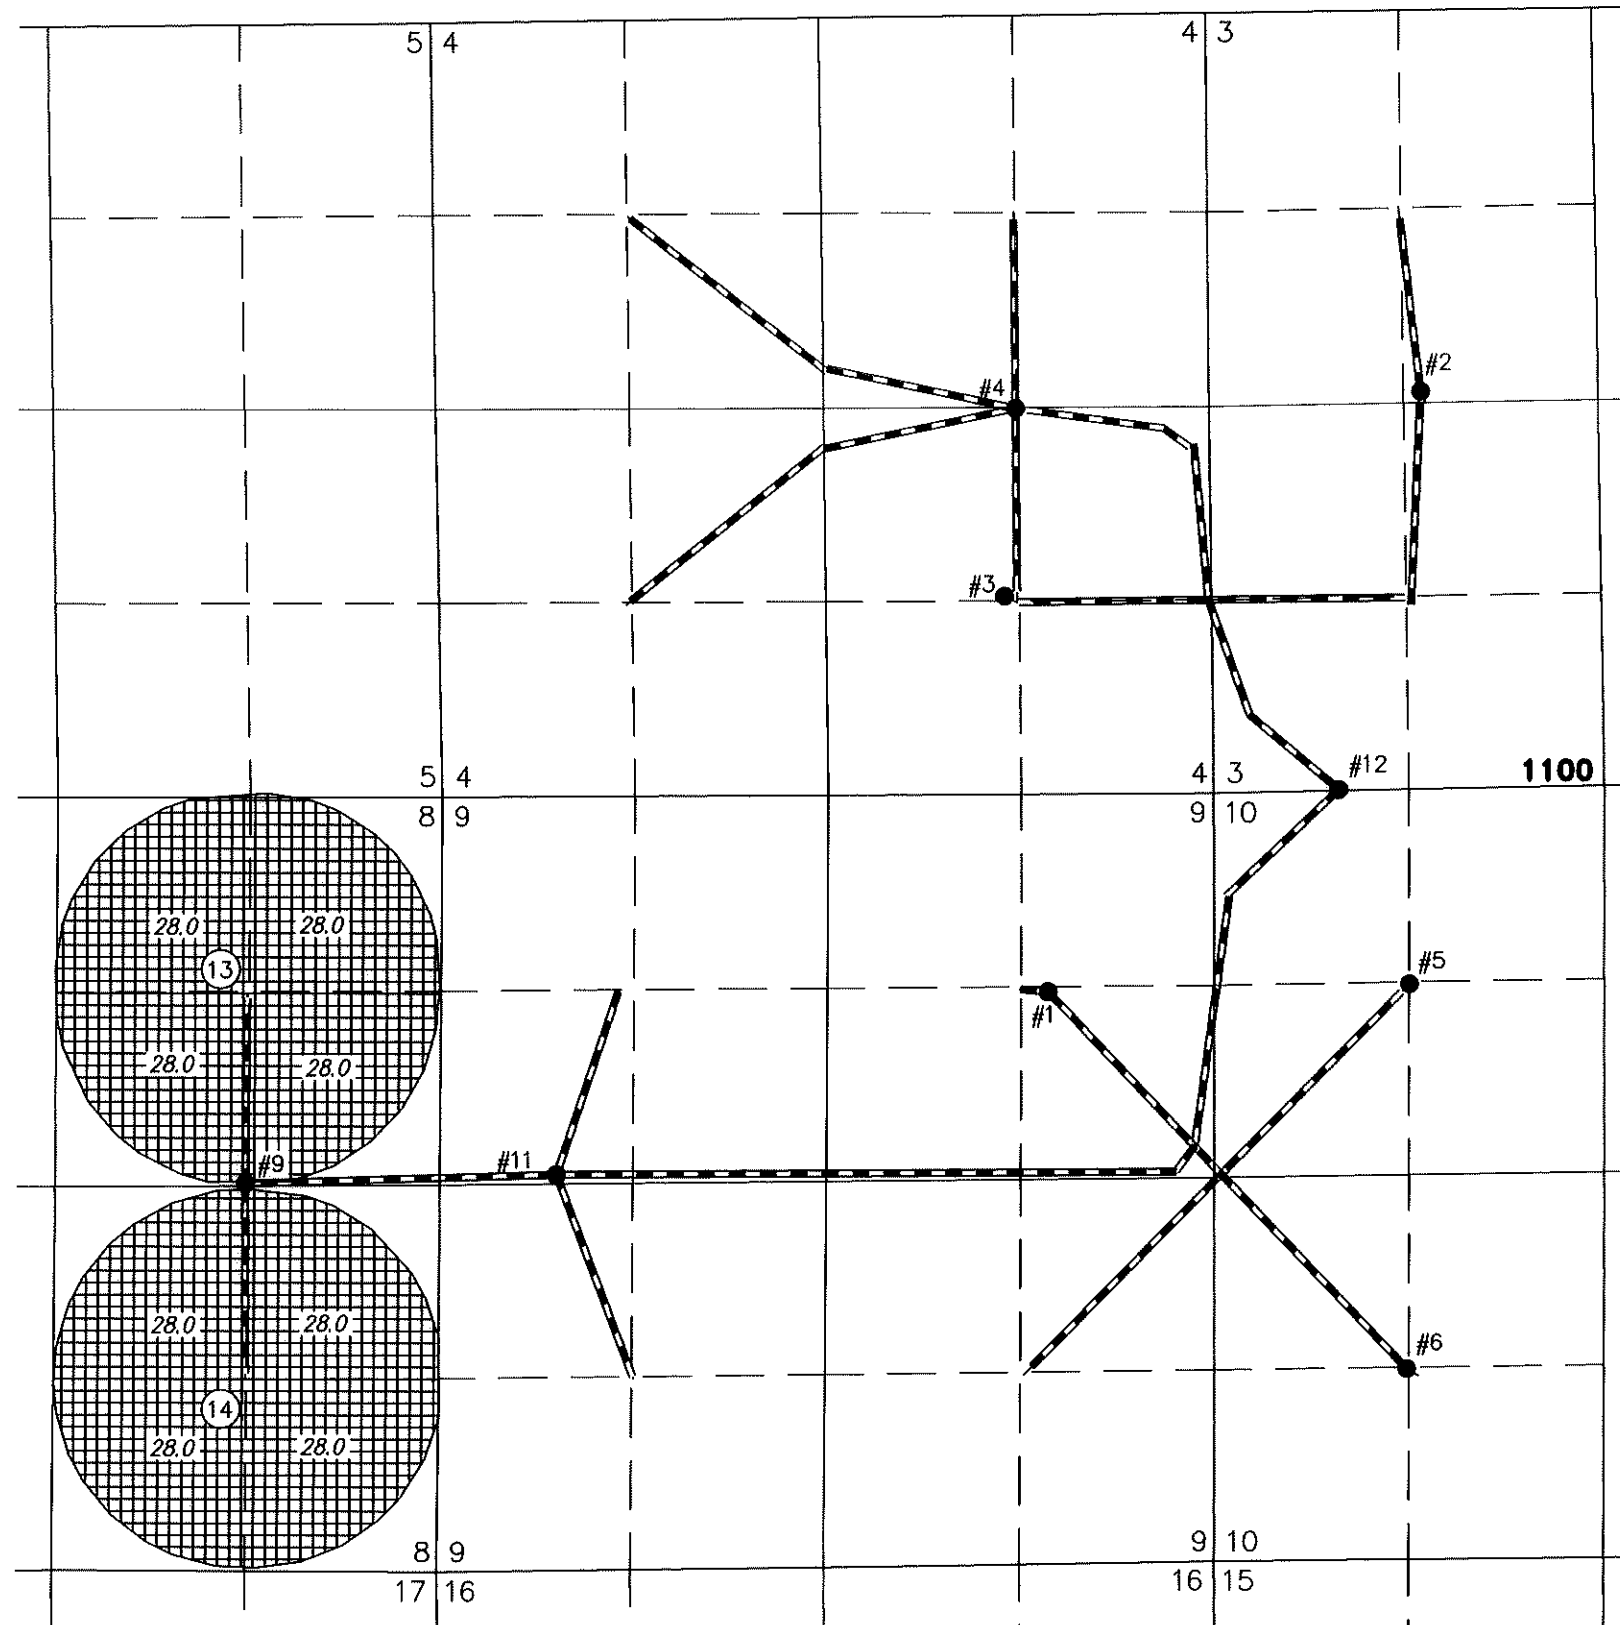

- **#1 (HARN 1668)**
LOCATED IN THE NE 1/4 NE 1/4 SECTION 9, T33S, R31E, W.M. AND 1320 FEET SOUTH AND 1200 FEET WEST FROM THE NE CORNER OF SAID SECTION.
FLOW METER IS ON PIPE 6' WEST FROM WELL.
- **#2 (HARN 1677-51860)**
LOCATED IN THE SE 1/4 NW 1/4 SECTION 3, T33S, R31E, W.M. AND 60 FEET NORTH AND 1340 FEET WEST FROM THE W 1/4 CORNER OF SAID SECTION.
FLOW METER IS ON PIPE 4' WEST FROM WELL.
- **#3 (HARN 50623)**
LOCATED IN THE NW 1/4 SE 1/4 SECTION 4, T33S, R31E, W.M. AND 1225 FEET SOUTH AND 1412 FEET WEST FROM THE E 1/4 CORNER OF SAID SECTION.
FLOW METER IS ON PIPE 2' EAST FROM WELL.
- **#4 (HARN 50481)**
LOCATED IN THE SE 1/4 NE 1/4 SECTION 4, T33S, R31E, W.M. AND 60 FEET NORTH AND 1320 FEET WEST FROM THE E 1/4 CORNER OF SAID SECTION.
FLOW METER IS ON PIPE 6.5' WEST FROM WELL.
- **#5 (HARN 1844)**
LOCATED IN THE NE 1/4 NW 1/4 SECTION 10, T33S, R31E, W.M. AND 1300 FEET SOUTH AND 1330 FEET EAST FROM THE NW CORNER OF SAID SECTION.
FLOW METER IS ON PIPE 6' EAST FROM WELL.
- **#6 (HARN 1843)**
LOCATED IN THE SE 1/4 SW 1/4 SECTION 10, T33S, R31E, W.M. AND 1320 FEET NORTH AND 1330 FEET EAST FROM THE SW CORNER OF SAID SECTION.
FLOW METER IS ON PIPE 5.5' EAST FROM WELL.
- **#9 (HARN 900/910)**
LOCATED IN THE SW 1/4 NE 1/4 SECTION 8, T33S, R31E, W.M. AND 2650 FEET SOUTH AND 1320 FEET EAST FROM THE N 1/4 CORNER OF SAID SECTION.
FLOW METER IS ON PIPE 5' WEST FROM WELL.
- **#11 (HARN 51959)**
LOCATED IN THE SW 1/4 NW 1/4 SECTION 9, T33S R31E, W.M. AND 2730 FEET NORTH AND 800 FEET EAST FROM THE SW CORNER OF SAID SECTION.
FLOW METER IS ON PIPE 6.5' WEST FROM WELL.
- **#12 (HARN 51938)**
LOCATED IN THE NW 1/4 NW 1/4 SECTION 10, T33S R31E, W.M. AND 0 FEET SOUTH AND 860 FEET EAST FROM THE NW CORNER OF SAID SECTION.
FLOW METER IS ON PIPE 6.0' SW OF WELL.

--- BURIED PIPE

224.0 ACRES IR AUTHORIZED FROM POA #1-6, 9, 11 & 12 BY T-12864 (G-10873).


PREPARED FOR:

WHITBY BROS. LAND/LIVESTOCK, LLC
62 W. JUNIPER ROAD
MESA, WA 99343

PREPARED BY:



ALL POINTS ENGINEERING AND SURVEYING, INC.
P.O. BOX 767 TERREBONNE, OR 97760
(541) 548-5833 www.APEandS.com

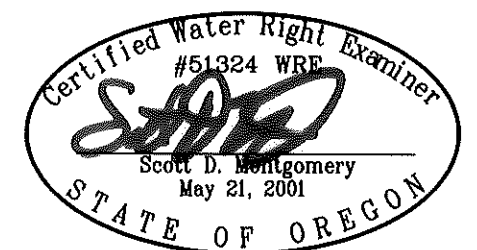

THIS MAP IS FOR THE PURPOSE OF LOCATING A WATER RIGHT ONLY AND HAS NO INTENT TO PROVIDE LEGAL DIMENSIONS OR THE LOCATION OF PROPERTY LINES.

RENEWAL DATE: 12/31/2020

14/000 2/18/2022

120264/5