

LEGEND

- SECTION LINE
- 1/4 1/4 LINE
- TAX LOT LINE
- ABOVEGROUND PIPE
- BURIED PIPE
- ROAD
- CANAL
- TL0000 TAX LOT NUMBER
- POA-1 (WELL)
- IRRIGATED ACREAGE UNDER TRANSFER T-12530
- TOTAL IRRIGATED ACRES
- 1/4 1/4 SECTION
- SECTION CORNER

WELL TIE

POA-1 (WELL): LOCATED 200 FEET SOUTH AND 50 FEET EAST FROM THE NW CORNER OF SECTION 12.

NOTES


1. THIS MAP WAS PREPARED FROM FIELD MEASUREMENTS, THE MOST CURRENT ON-LINE BING AERIAL, AND KLAMATH COUNTY TAX MAP 39-11.
2. THIS MAP IS NOT INTENDED TO PROVIDE LEGAL DIMENSIONS OR LOCATIONS OF PROPERTY OWNERSHIP LINES.
3. FOR TAX LOT INFORMATION, SEE TAX MAP INCLUDED WITH THIS APPLICATION.
4. DATE OF PRIORITY FOR TRANSFER T-12530 IS MAY 10, 1976.

Stephen P. Tenold
APPLICANT

Carrie Rose Tenold
APPLICANT

RECEIVED
DEC 18 2019
OWRD

RECEIVED
OCT 03 2019
OWRD

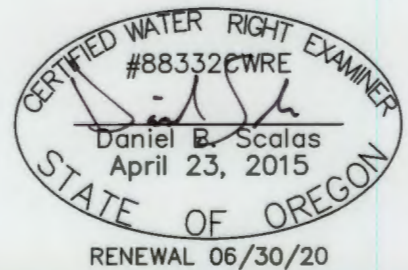

AL ADKINS ENGINEERING & SURVEYING o / 541.884.4666 w / AdkinsEngineering.com
1435 ESPLANADE AVENUE, KLAMATH FALLS, OR 97601
SERVING S. OREGON & N. CALIFORNIA

CLAIM OF BENEFICIAL USE AND FINAL PROOF MAP

FOR
CARRIE ROSE TENOLD & STEPHEN P. TENOLD
T39S, R11E, SEC. 12, WM
KLAMATH COUNTY, OREGON
TRANSFER T-12530