


RECEIVED  
DEC 07 2021  
OWRD

# T.8 S.R.2W.W.M.

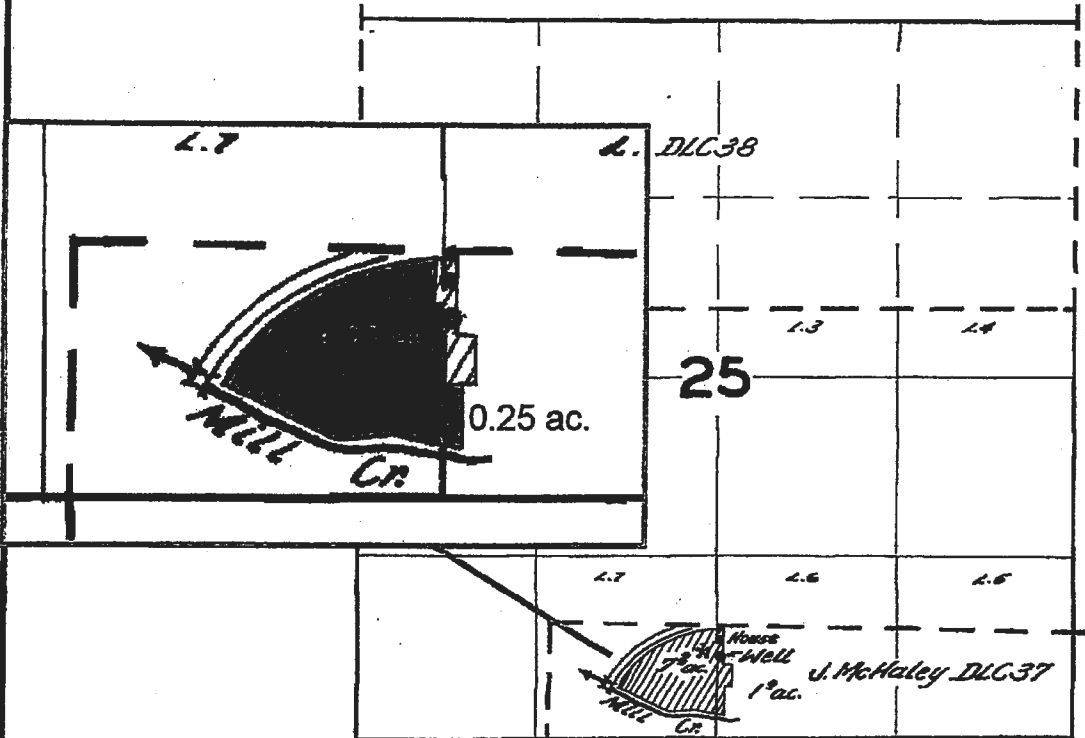

\* Acreage on map is not accurate and does not correspond with Certificate. 0.07 acres in SESW and 0.75 acres in SWSE will not be diminished.

## FINAL PROOF SURVEY UNDER

Application No. G-100 Permit No. G-19  
IN NAME OF

Calvin D. Garver

Surveyed April 2, 1957, by C.D. Garver