

400 800
SCALE IN FEET

WALLOWA COUNTY


REVISED APPROX
SCALE
1" = 600 FEET

RECEIVED

JAN 09 2006

WATER RESOURCES DE
SALEM, OREGON

SEE MAP 35 45

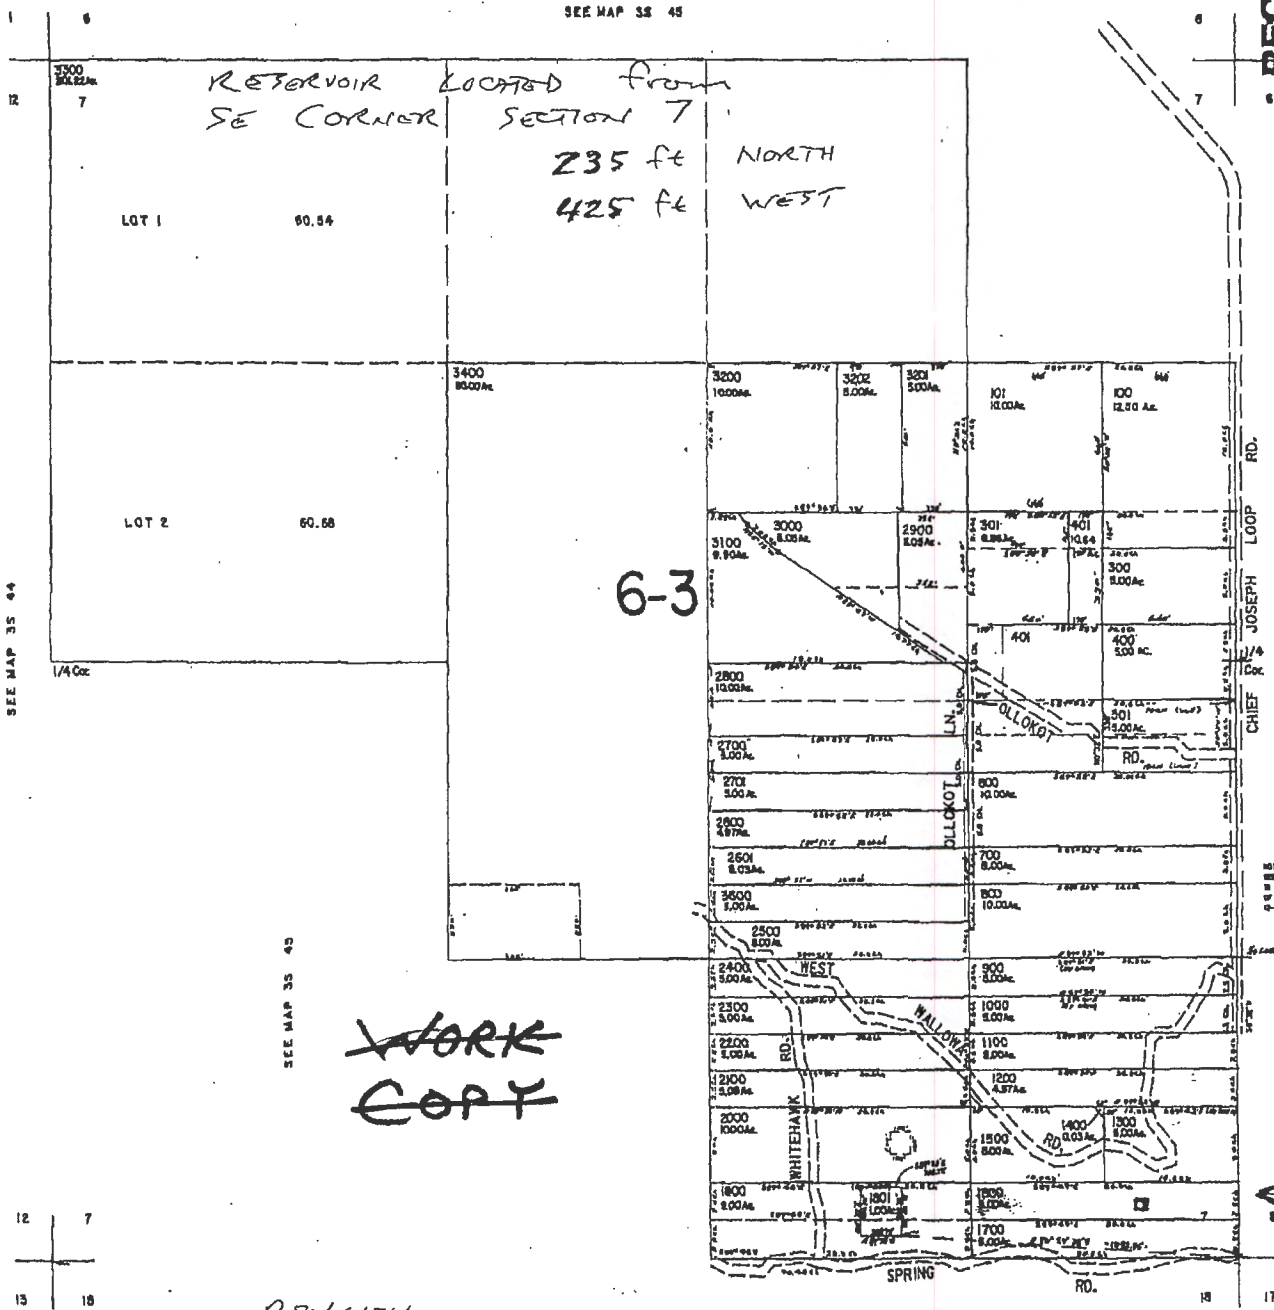

CANCELLED NO.
200 THRU
202
302
402
500
1900
3500

SEE MAP 35 45 8

NOTE: SEE ORDER 200-200 IN THE MATTER OF LEGALIZATION OF MAPS IN THE COUNTY OF WALLOWA, OREGON

SEE MAP 35 45 BCC

Tax Lot 1600
Reservoir

~~WORK COPY~~

APP NO R86474

SEE MAP 35 45

Self certification claim map
2/5/18

RECEIVED

MAR 28 2018

OWRD