


Claim of Beneficial Use Map

Section 5, Township 2S, Range 5E, W.M.

12.2 acres in SW 1/4 of SE 1/4

Application G-17216 / Permit G-16599

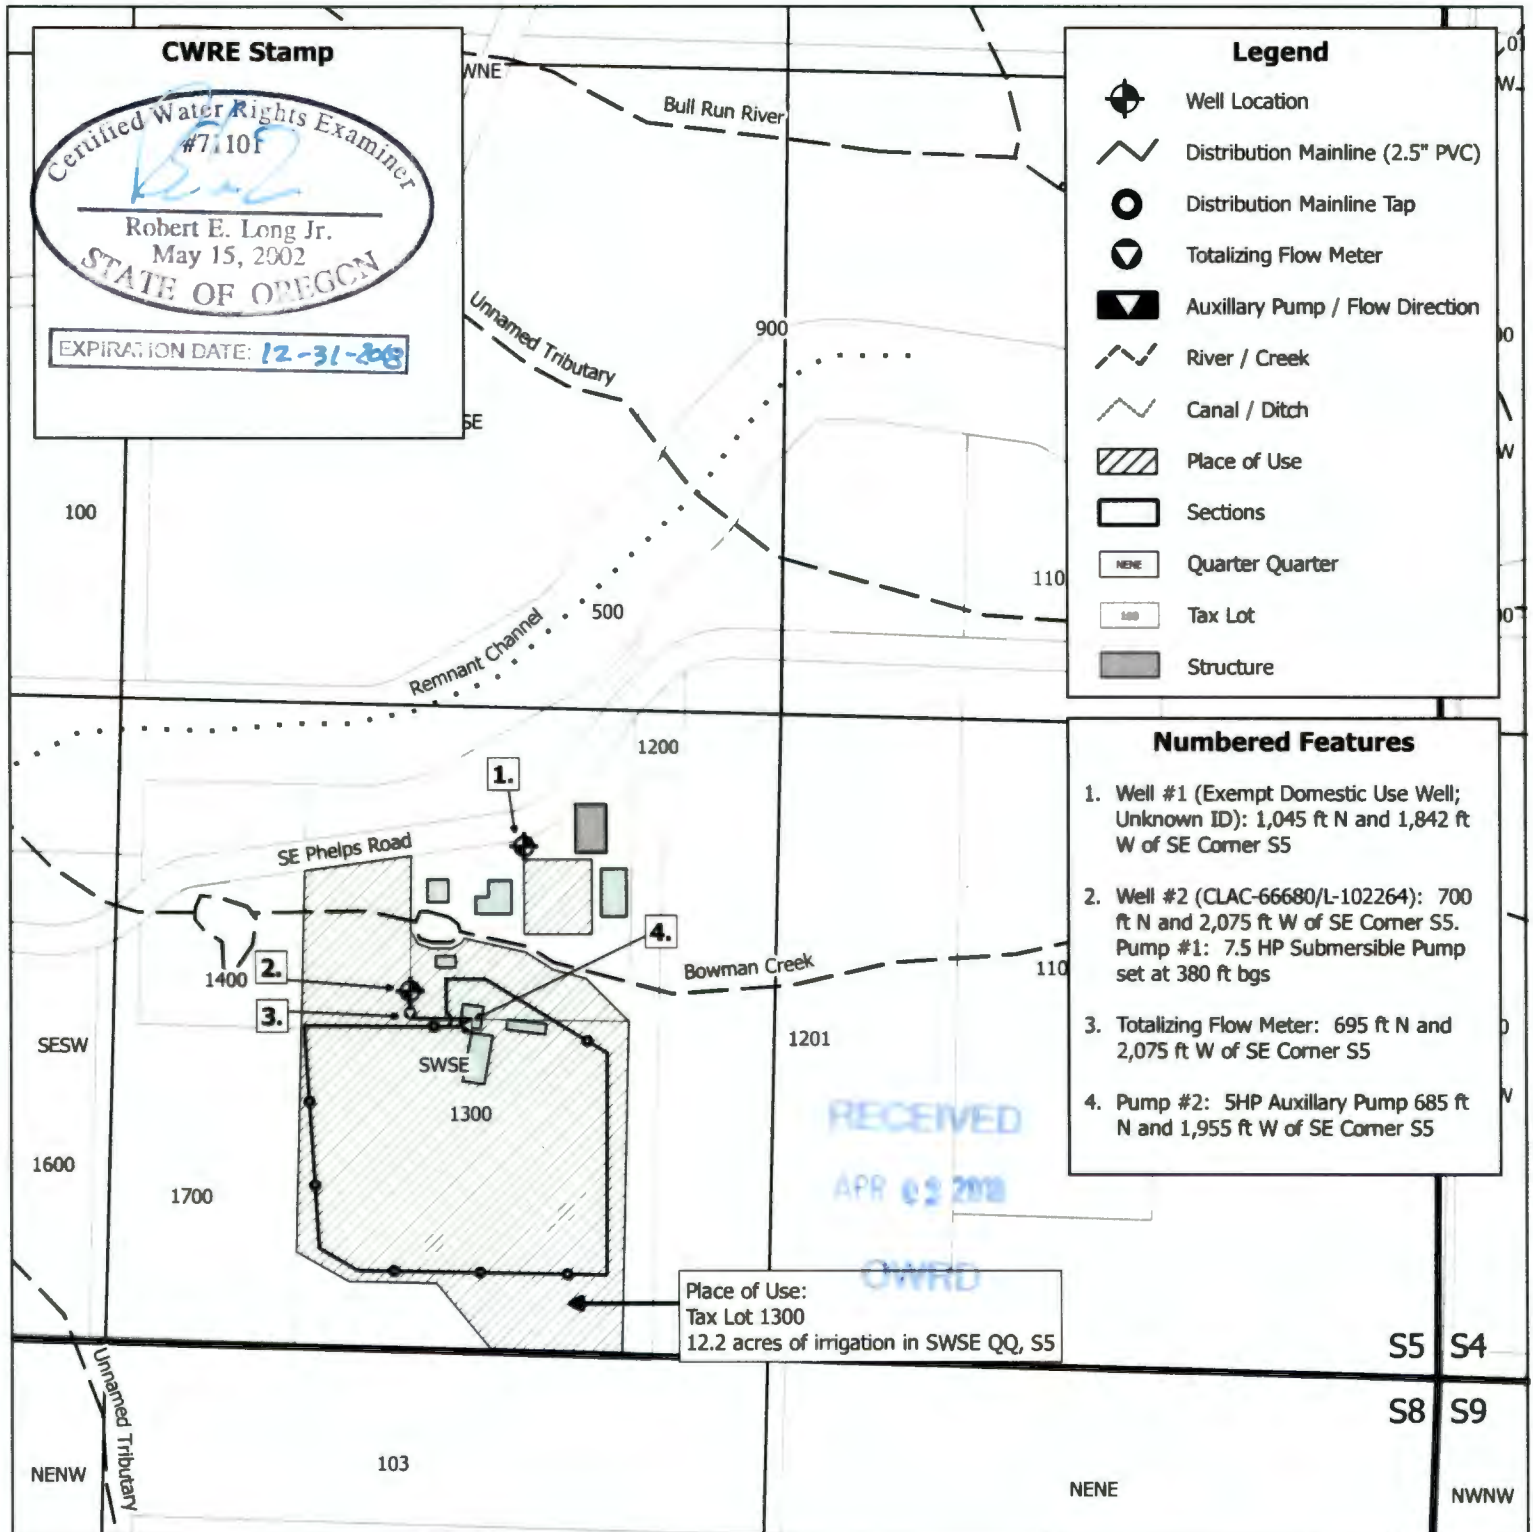

CwM-H2O

Complete Water Management



1319 SE MLK Jr. Blvd, Suite 204
Portland, Oregon 97214
(503) 954-1326

This map is not intended to provide legal dimensions or property ownership lines.

1	11/6/2017	RMD	DRAFT
No.	Date	By	Revisions



0 200 400 ft



Proj#: 1717001 - Slice of Heaven Farm CBU

43464 SE Phelps Road
Sandy, Oregon 97055