


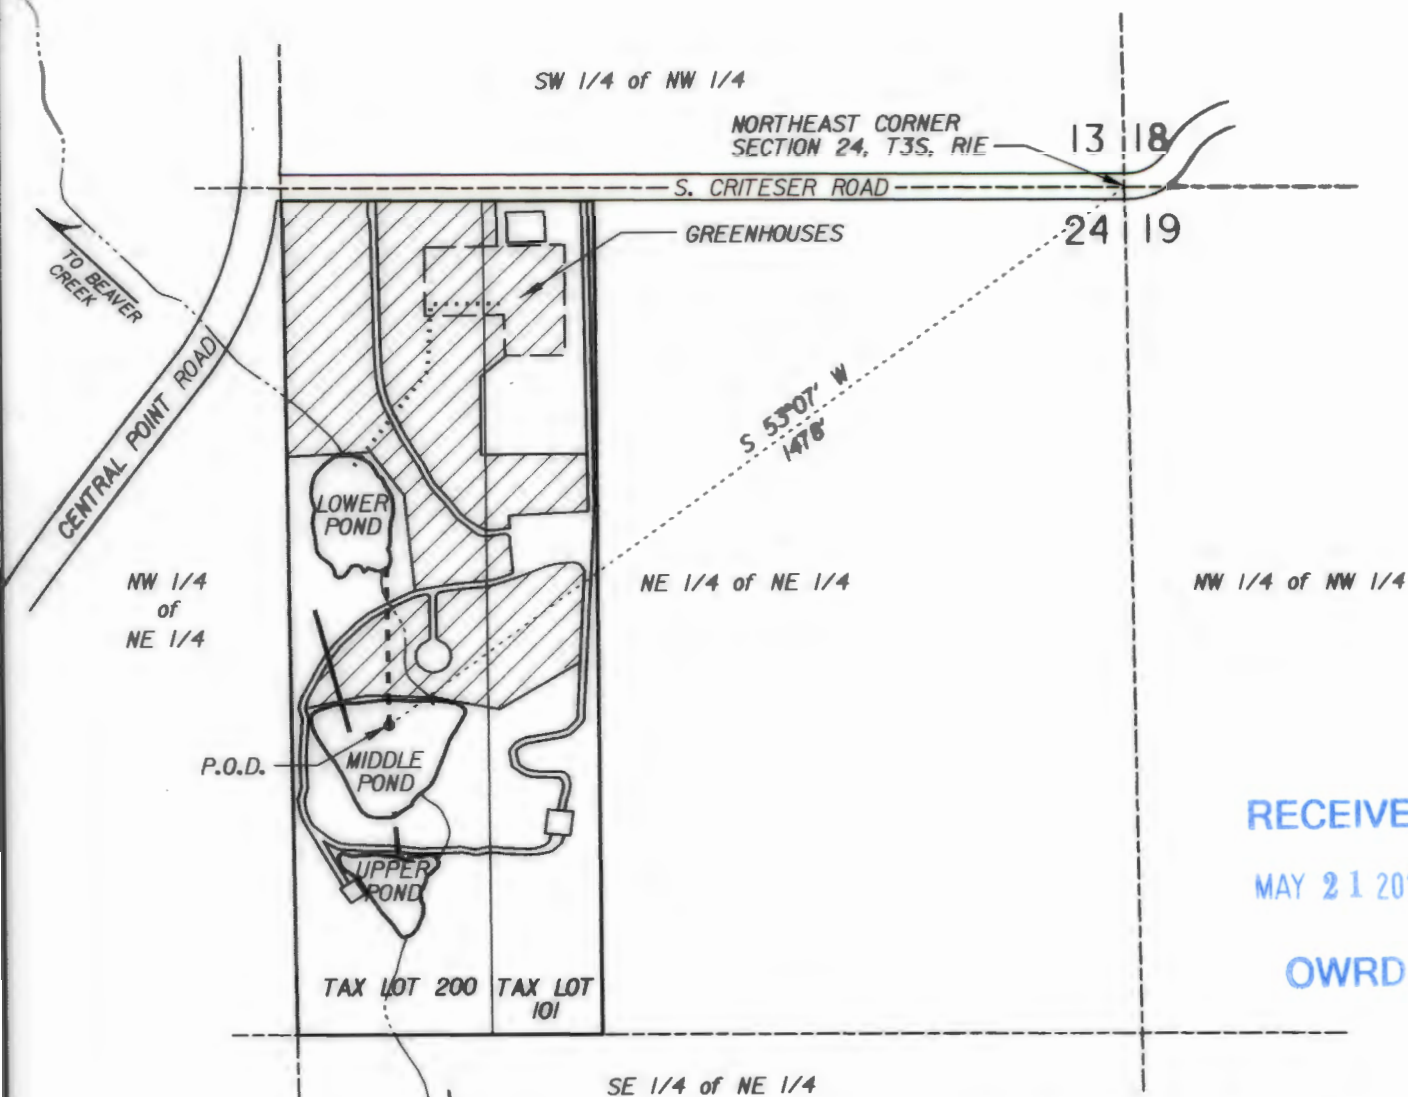

RECEIVED

MAY 21 2018

OWRD

LEGEND:

- IRRIGATED LAND
- BURIED 10" ADS OVERFLOW
- BURIED 8" PVC MAINLINE
- BURIED 6" ADS MAINLINE
- BURIED 2" PVC MAINLINE
- STRUCTURES

NOTES:

THIS DRAWING IS A PROOF SURVEY FOR A CLAIM OF BENEFICIAL USE TO PERFECT A RESERVOIR STORAGE RIGHT. IT IS NOT A LAND SURVEY. PROPERTY LINES AND/OR OTHER LINES OF OCCUPATION SHOWN HEREON ARE NOT REPRESENTED BY THE UNDERSIGNED TO MEET ACCURACY STANDARDS OF LAND SURVEYS.

SCALE: 1" = 300'


NE 1/4, NE 1/4
SECTION 24, T.3S., R.1E., W.M.
CLACKAMAS COUNTY, OREGON

5.4 TOTAL ACRES OF PASTURE,
NURSERY STOCK, GREENHOUSES
& GRAPES UNDER IRRIGATION

APPLICATION No. S-86097

PERMIT No. R-14179

BURL MOSTUL RESERVOIR STORAGE PROOF SURVEY

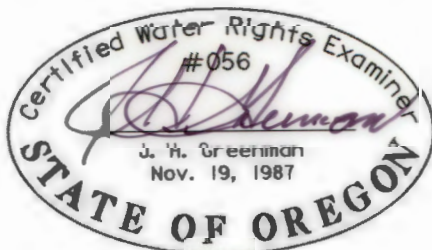

2018/05/14



L:\HRS_1670\ 1670_DGN\ 1670_POND_SURVEY_R1.DGN