

CLAIM OF BENEFICIAL USE MAP

APPLICATION G-15333 PERMIT G-15091
IRRIGATION

RECEIVED BY OWRD

FOR

EDWARD AND PAULA SAVAGE
2543 OLD MILITARY ROAD
CENTRAL POINT, OREGON 97502
SITUATED IN

OCT 28 2016

SALEM, OR


SECTION 17, TOWNSHIP 37 SOUTH, RANGE 2 WEST, W.M.
JACKSON COUNTY, OREGON



This map is not intended to provide legal dimensions or locations of property ownership lines.


EHM-October 6, 2015
RH2 ENGINEERING, INC.
www.rh2.com 1.800.720.8052

0 200 400
SCALE: 1"=400'

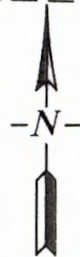

LEGEND

- POINT OF APPROPRIATION
1,825' WEST AND 16' SOUTH OF
E 1/4 CORNER SECTION 17
- 1/4-1/4 SECTION LINE
- WATERLINE (BURIED-APPRX. LOCATION)
- ▨ PLACE OF USE - IRRIGATION

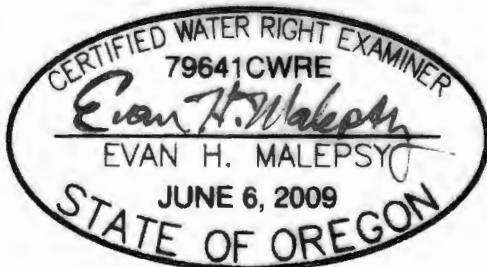

RENEWS: 12/31/2016