

CLAIM OF BENEFICIAL USE FINAL PROOF SURVEY MAP
FOR S. LEE WILSON
PERMIT NUMBER: G-17951

LOCATED IN THE SW 1/4 SW 1/4 SEC. 3, SE 1/4 SE 1/4 SEC. 4, NE 1/4 NE 1/4 SEC. 9
AND NW 1/4 NW 1/4 SEC. 10, T. 25 S., R. 31 E., W.M., HARNEY COUNTY, OREGON

RECEIVED

SEP 21 2020

OWRD

PERMIT 160.00 AC
ACTUAL 130.85 AC

LEGEND

--- EX. PROPERTY LINE
--- SECTION LINES
--- 6 IRR WL --- 6 IRR WL --- EX. IRRIGATION LINE




EX. WELLS



PIVOT #1




PIVOT #2

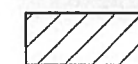

PIVOT #3




PIVOT #4

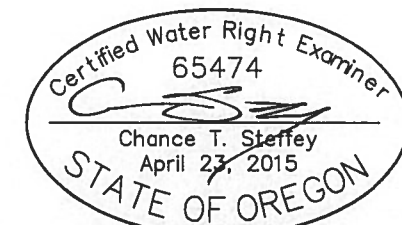

RENEWS: June 30, 2022

I, CHANCE T. STEFFEY, CERTIFIED WATER RIGHT EXAMINER IN THE STATE OF OREGON, HEREBY CERTIFY THE ABOVE FINAL PROOF MAP WAS PREPARED UNDER MY DIRECT SUPERVISION.

THE PREPARATION OF THIS MAP IS FOR THE PURPOSE OF IDENTIFYING THE LOCATION OF THE WATER RIGHT ONLY AND HAS NO INTENT TO PROVIDE DIMENSIONS OR LOCATIONS OF PROPERTY OWNERSHIP LINES.

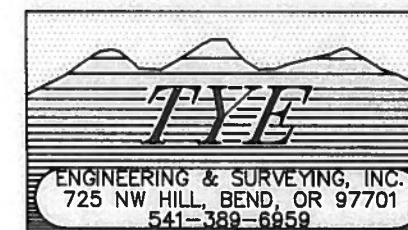

TITLE: FINAL PROOF SURVEY MAP	
JOB NO: 2017 - WRIGHT FARMS, LLC	
SCALE: 1"=400'	DRAWN BY: P.A.T.
FIELD BOOK NO:	DATE: 9/2/2020
DWG NAME:	SHEET: 1 OF 1

