

CLAIM OF BENEFICIAL USE MAP


FOR
CHRIS + JOAN HORTON

LOCATED IN
THOMAS W. BERRY D.L.C. NO. 42
SEC. 4, T. 10 S., R. 5 W., W.M.

POLK COUNTY, OREGON

MARCH 28, 2018

PERMIT R-15120
APPLICATION R-88073

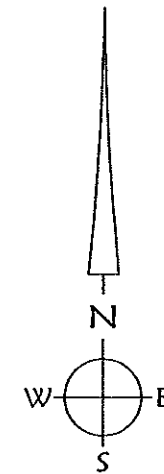

0 200 400 800 FT.

SCALE: 1" = 400'

LEGEND:

- ⊗ POINT OF DIVERSION (POD)
- LOCATION OF STAFF GAUGE AND OUTLET
- WL— EXISTING 10"Ø GRAVITY FLOW WATER PIPELINE
- LOCATION OF POND AUTHORIZED BY PERMIT R-15120. 43.0 ACRE-FT OF STORAGE ALLOWED, 37.0 ACRE-FT DEVELOPED.

POINT OF DIVERSION

P.O.D. #1 - NOT DEVELOPED

P.O.D. #2
2660' SOUTH + 1360' WEST FROM THE
NORTHEAST CORNER OF SECTION 4.

NOTE:

THIS MAP IS NOT INTENDED TO PROVIDE LEGAL DIMENSIONS OR LOCATION OF PROPERTY OWNERSHIP. INFORMATION ON THIS MAP IS COMPILED FROM 2018 POLK COUNTY GIS DATA, 2016 AERIAL PHOTOGRAPHY, RECORD WATER RIGHTS INFORMATION, PLAN DRAWINGS AND SCHEMATICS, AND IN-FIELD OBSERVATIONS.

Date: 3/28/2018

Time: 11:15

Scale: 1=1(P5)

File: dwg\2018\18-36\18-36-cobu.dwg (lan)

SHEET 1 OF 1



EXPIRES: 12/31/2018

RECEIVED

APR 06 2018

OWRD



K & D ENGINEERING, Inc.
278 N.W. Hickory Street P.O. Box 725
Albany, Oregon 97321
(541) 928-2583