


COBU MAP #1130

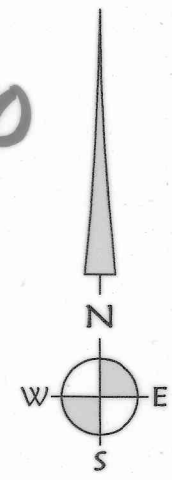

0 200 400 800 FT.  
SCALE: 1" = 400'

RECEIVED  
APR 06 2018  
OWRD  
RECEIVED  
06 2018  
OWRD

CLAIM OF BENEFICIAL USE MAP

FOR  
CHRIS + JOAN HORTON

LOCATED IN

THOMAS W. BERRY D.L.C. NO. 42  
SEC. 4 + NW 1/4 SEC. 3, T. 10 S., R. 5 W., W.M.  
SE 1/4 SEC. 33 + SW 1/4 SEC. 34, T. 9 S., R. 5 W., W.M.

POLK COUNTY, OREGON

MARCH 28, 2018

PERMIT S-54979  
APPLICATION S-88140



LEGEND:

- ⊗ POINT OF DIVERSION (POD) + PUMP LOCATION
- ⊠ TOTALIZING FLOW METER LOCATION
- WL— EXISTING WATER PIPELINE, SIZE VARIES 1"-4"
- 6.9 ACRES AMOUNT OF ACREAGE IRRIGATED PER QUARTER-QUARTER SECTION IRRIGATED UNDER PERMIT S-54979.
- AREA IRRIGATED UNDER PERMIT S-54979  
107.6 ACRES TOTAL.
- LOCATION OF POND AUTHORIZED BY PERMIT R-15120.  
43.0 ACRE-FT OF STORAGE ALLOWED, 37.0 ACRE-FT DEVELOPED

POINT OF DIVERSION

IRRIGATION POD  
1100' SOUTH + 2270' WEST FROM THE  
NORTHEAST CORNER OF SECTION 4.

NOTE:

THIS MAP IS NOT INTENDED TO PROVIDE LEGAL DIMENSIONS OR LOCATION OF PROPERTY OWNERSHIP. INFORMATION ON THIS MAP IS COMPILED FROM 2018 POLK COUNTY GIS DATA, AERIAL PHOTOGRAPHY, AND RECORD WATER RIGHTS INFORMATION.

**K & D ENGINEERING, Inc.**  
276 N.W. Hickory Street P.O. Box 725  
Albany, Oregon 97321  
(541) 928-2583

Date: 3/28/2018 Time: 11:15

Scale: 1"=165'  
File: dwg\2018\18-36\18-36-cobu.dwg (lan)

1130

