

**T8S R24E, WM
WHEELER COUNTY, OR**



0 400
Feet

1" = 400'



Pond

----- Stream

———— Section


----- Quarter Quarter

Center of Pond Locations:

Pond #2: 60' N, 2180' E of the SW Cor Sec 3

Pond #3: 220' N, 2250' E of the SW Cor Sec 3

Pond #4: 190' S, 440' E of the SW Cor Sec 3

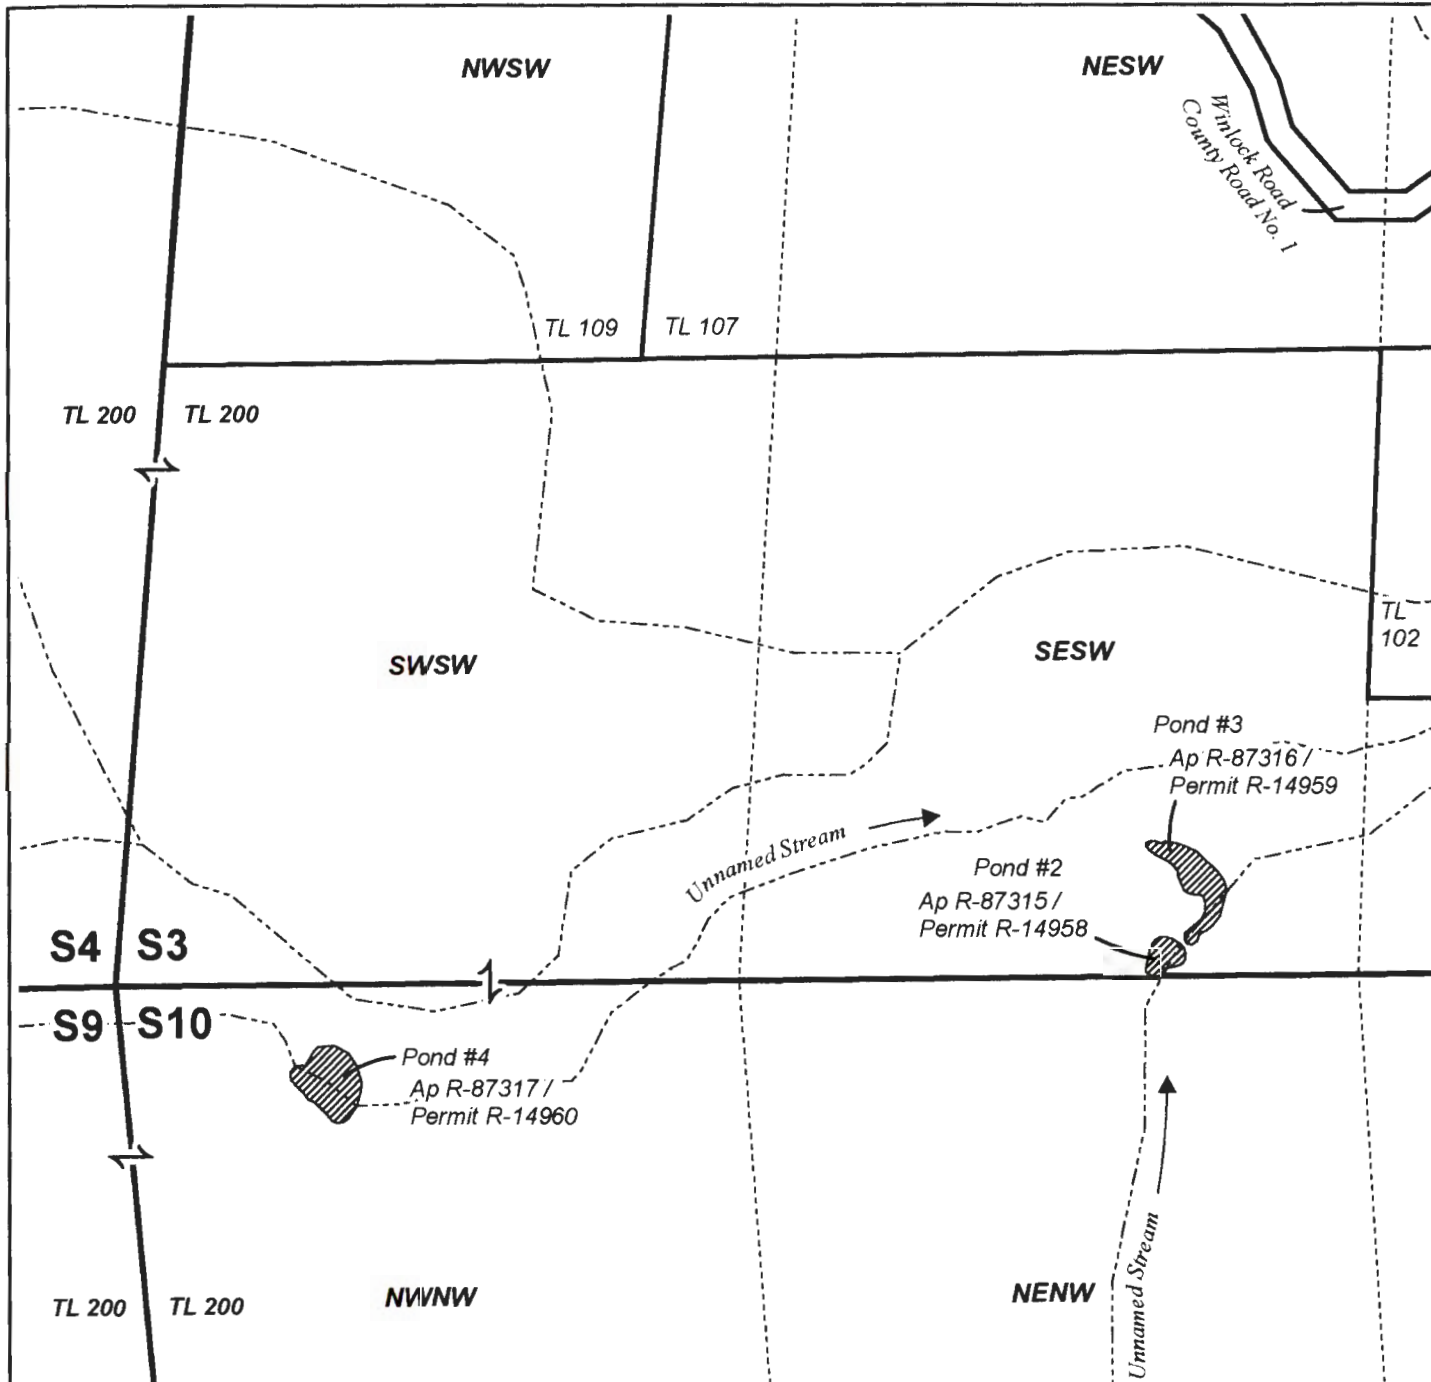

RECEIVED

MAR 10 2021

OWRD



**CLAIM OF BENEFICIAL USE MAP
GOBET RANCH**

Date: 12/8/2020

This map is not intended
to provide legal dimensions
or locations of property
ownership lines.

WATER RIGHT SERVICES, LLC

PO BOX 1830, BEND, OR 97709

WWW.OREGONWATER.US CCB # 197121

johnshort@usa.com

541-389-2837