



**T8S R24E, WM
WHEELER COUNTY, OR**

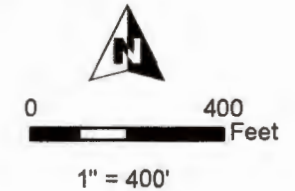

-  Pond
-  Stream
-  Section
-  Quarter Quarter

Center of Pond Locations:
 Pond #2: 60' N, 2180' E of the SW Cor Sec 3
 Pond #3: 220' N, 2250' E of the SW Cor Sec 3
 Pond #4: 190' S, 440' E of the SW Cor Sec 3

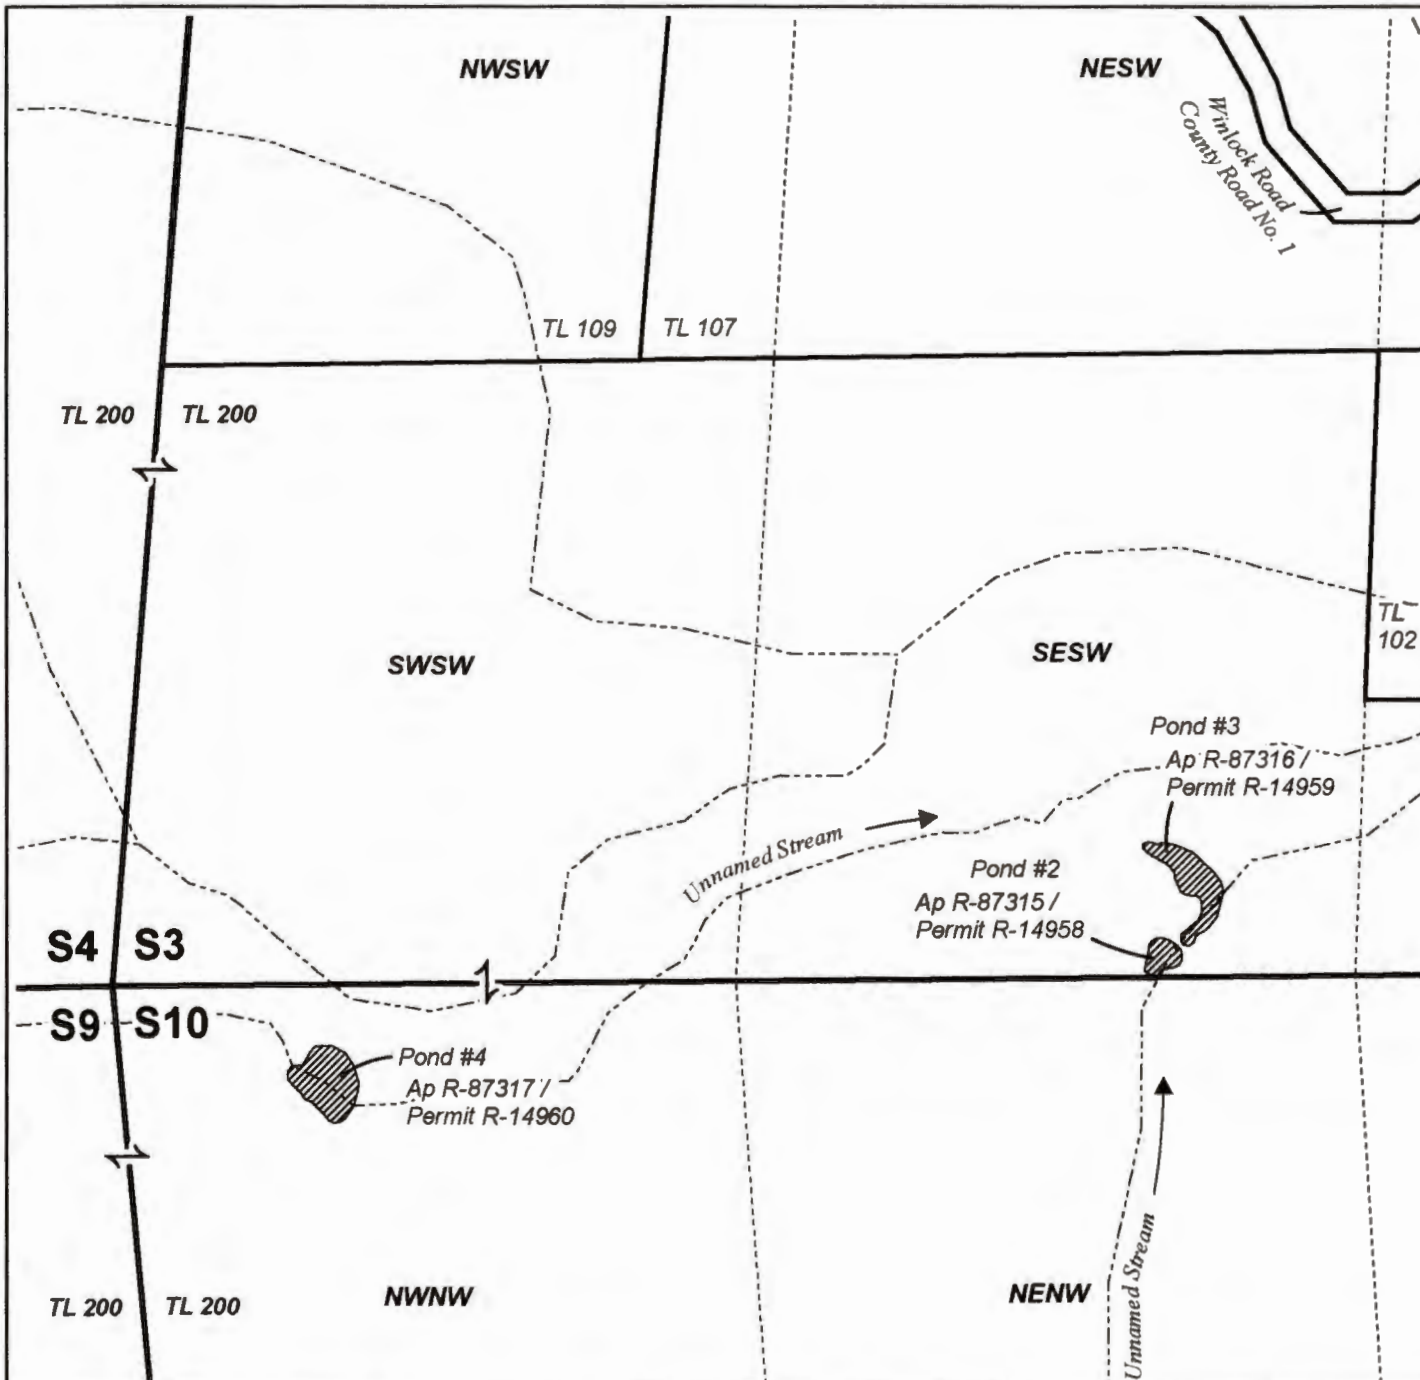

RECEIVED

MAR 10 2021

OWRD



**CLAIM OF BENEFICIAL USE MAP
GOBET RANCH**

Date: 12/8/2020

This map is not intended
to provide legal dimensions
or locations of property
ownership lines.

WATER RIGHT SERVICES, LLC
 PO BOX 1830, BEND, OR 97709
WWW.OREGONWATER.US CCB # 197121
 johnshort@usa.com 541-389-2837