


T. 3 S. R. 1 W. W. M.

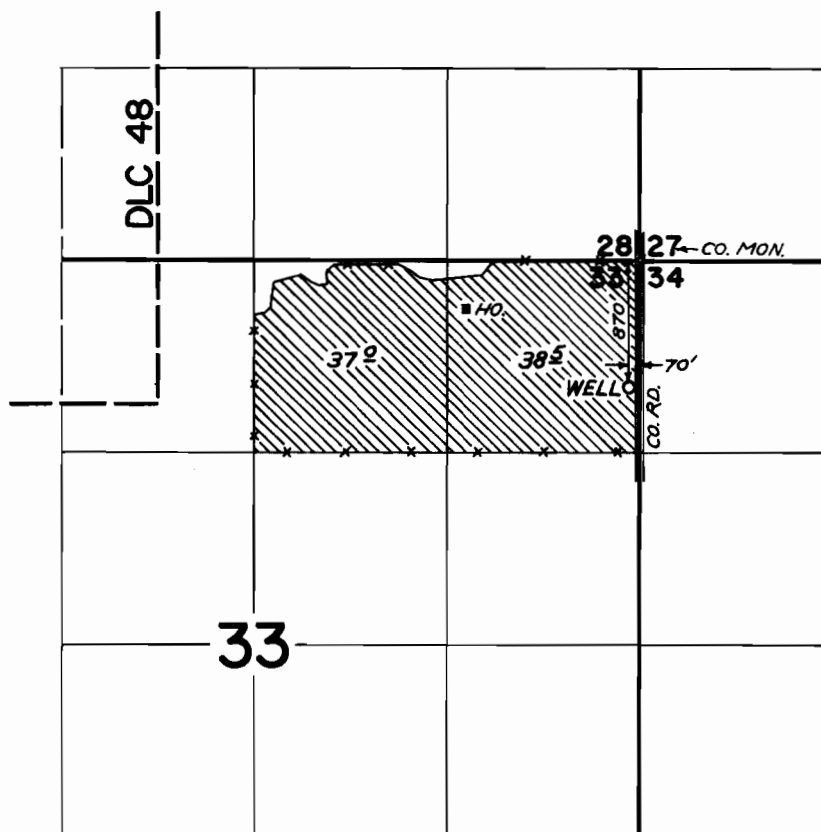

FINAL PROOF SURVEY
UNDER

Application No. G-3496 Permit No. G-3293
IN NAME OF

PAUL H. DAILY

Surveyed JULY 13 1971, by GREG BACA