



**T1N R18E, WM,
SHERMAN COUNTY, OR**

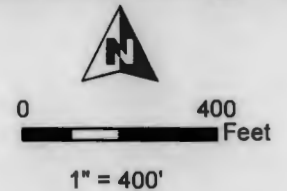

- Well & Meter
- Unnamed Intermittent Stream
- POI IR
- Section
- Quarter Quarter
- Tax Lot

**Well (SHER 50344/L-98286) Location:
450' N, 360' W of S 1/4 Cor Sec 22**

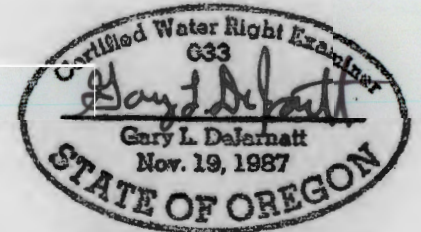

RENEWAL DATE 12/31/2021

RECEIVED

JUN 11 2021

OWRD




NWSW

NESW

SWSW

SESW

1.5 AC.

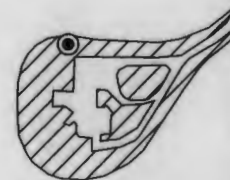

TL 3103

TL 3900

TL 3103

S21 S22

S28 S27

**CLAIM OF BENEFICIAL USE MAP
Weedman Ranches, Inc.**

Date: 5/16/2021

Ap. G-18167 Permit G-17754

This map is not intended
to provide legal dimensions
or locations of property
ownership lines.

Project #20n95

WATER RIGHT SERVICES, LLC
PO BOX 1830, BEND, OR 97709
WWW.OREGONWATER.US CCB # 197121
johnshort@usa.com 541-389-2837