


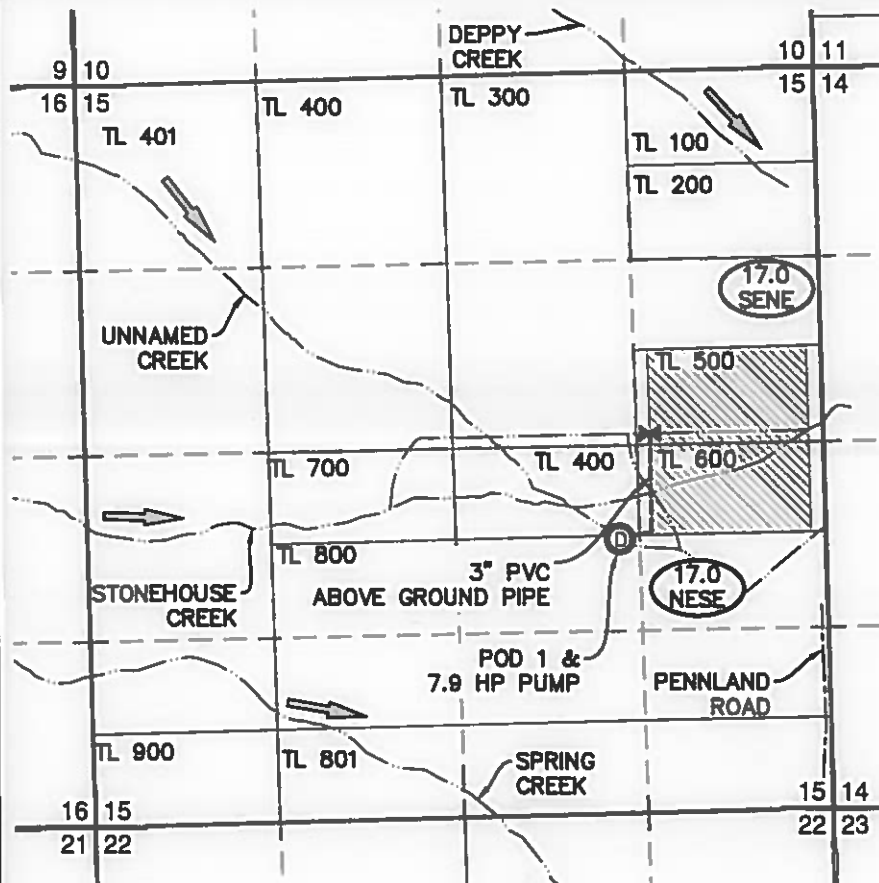

LEGEND	
	SECTION LINE
	1/4 1/4 LINE
	TAX LOT LINE
	DITCH/CREEK
	⊙ ROAD
	ABOVE GROUND PIPE
	FLOW DIRECTION
	SECTION CORNER
TL 0000	TAX LOT NUMBER
	POD
	PARSHALL FLUME
	IRRIGATED UNDER PERMIT S-55258
	IRRIGATED ACRES
	1/4 1/4 SECTION

RECEIVED

DEC 23 2020



OWRD

NOTES:

1. THIS MAP WAS PREPARED FROM FIELD MEASUREMENTS, NAIP 2020 AERIAL PHOTOGRAPHY, HARNEY COUNTY TAX MAPS, AND OREGON GLO MAPS.
2. THE PURPOSE OF THIS MAP IS TO IDENTIFY THE LOCATION OF THE WATER RIGHT ONLY, AND IS NOT INTENDED TO PROVIDE DIMENSIONS OR LOCATION OF PROPERTY LINES.
3. DATE OF PRIORITY FOR THIS WATER RIGHT IS JULY 31, 2008.

POD LOCATION:

POD 1: T35S, R33E, SECTION 15, W.M.; 1890' NORTH & 1510' WEST FROM THE SOUTHEAST CORNER OF SECTION 15.

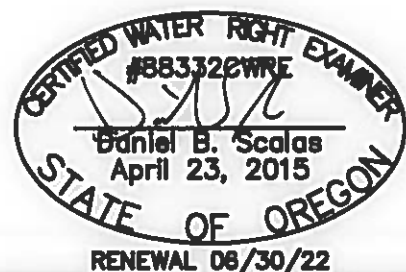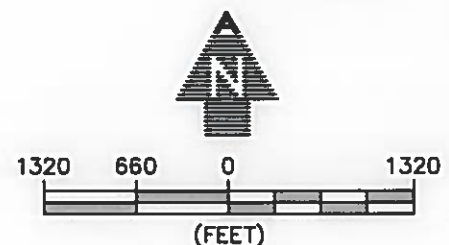

AL ADKINS
ENGINEERING & SURVEYING

o / 541.884.4666
w / AdkinsEngineering.com

1435 ESPLANADE AVENUE, KLAMATH FALLS, OR 97601

SERVING S. OREGON & N. CALIFORNIA

ENGINEERING • SURVEYING • PLANNING • TESTING

CLAIM OF BENEFICIAL USE AND FINAL PROOF MAP

FOR

GEORGE STROEMPLE
T35S, R33E, SEC. 15, WM
HARNEY COUNTY, OREGON
PERMIT S-55258
APPLICATION S-87246