


# T.7S. R.1W. Section 17, W.M.

POD is located SW NE, Section 17,  
T.7S, R.1W. Lot 2, W.M.

 Area (36.88 Acres) irrigated under  
Certificate 20059, changed by T-12599.

----- Tax lot boundary

— . — Donation Land Claim boundary

..... Water main line



Allister  
DLC 49

*June 30 2021*

SE NW

SW NE

SE NE

TL 07 1W 17 700

Unnamed  
Stream

4.28

14.0

6.8

11.8


Lot 3

Lot 2

POD

Beaver Creek

Scale: 1" = 400'

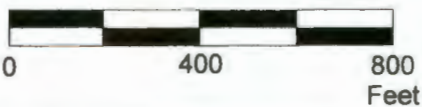

This map was prepared for the purpose of identifying the  
location of a water right only and is not intended to provide legal  
dimensions or location of property ownership lines.

Claim of Beneficial Use Map  
T-12559, Certificate 20059

Bryan and Amy Schurter  
T.7S. R.1W. Section 17, W.M.

Pacific Hydro-Geology Inc.

11/2019

