

DOAN M. HAMILTON

 May 10, 2012

 June 30, 2021

T.7S. R.1W. Section 17, W.M.

POD 1 is located 590 feet south and 1,180 feet west from the SE corner, DLC 49.


POD 2 is located SW NE, Section 17, T.7S, R.1W., Lot 2, W.M.

Area (10.0 Acres) authorized under Certificate 28253, changed by T-12559.


Tax lot boundary

Donation Land Claim boundary

Water main line

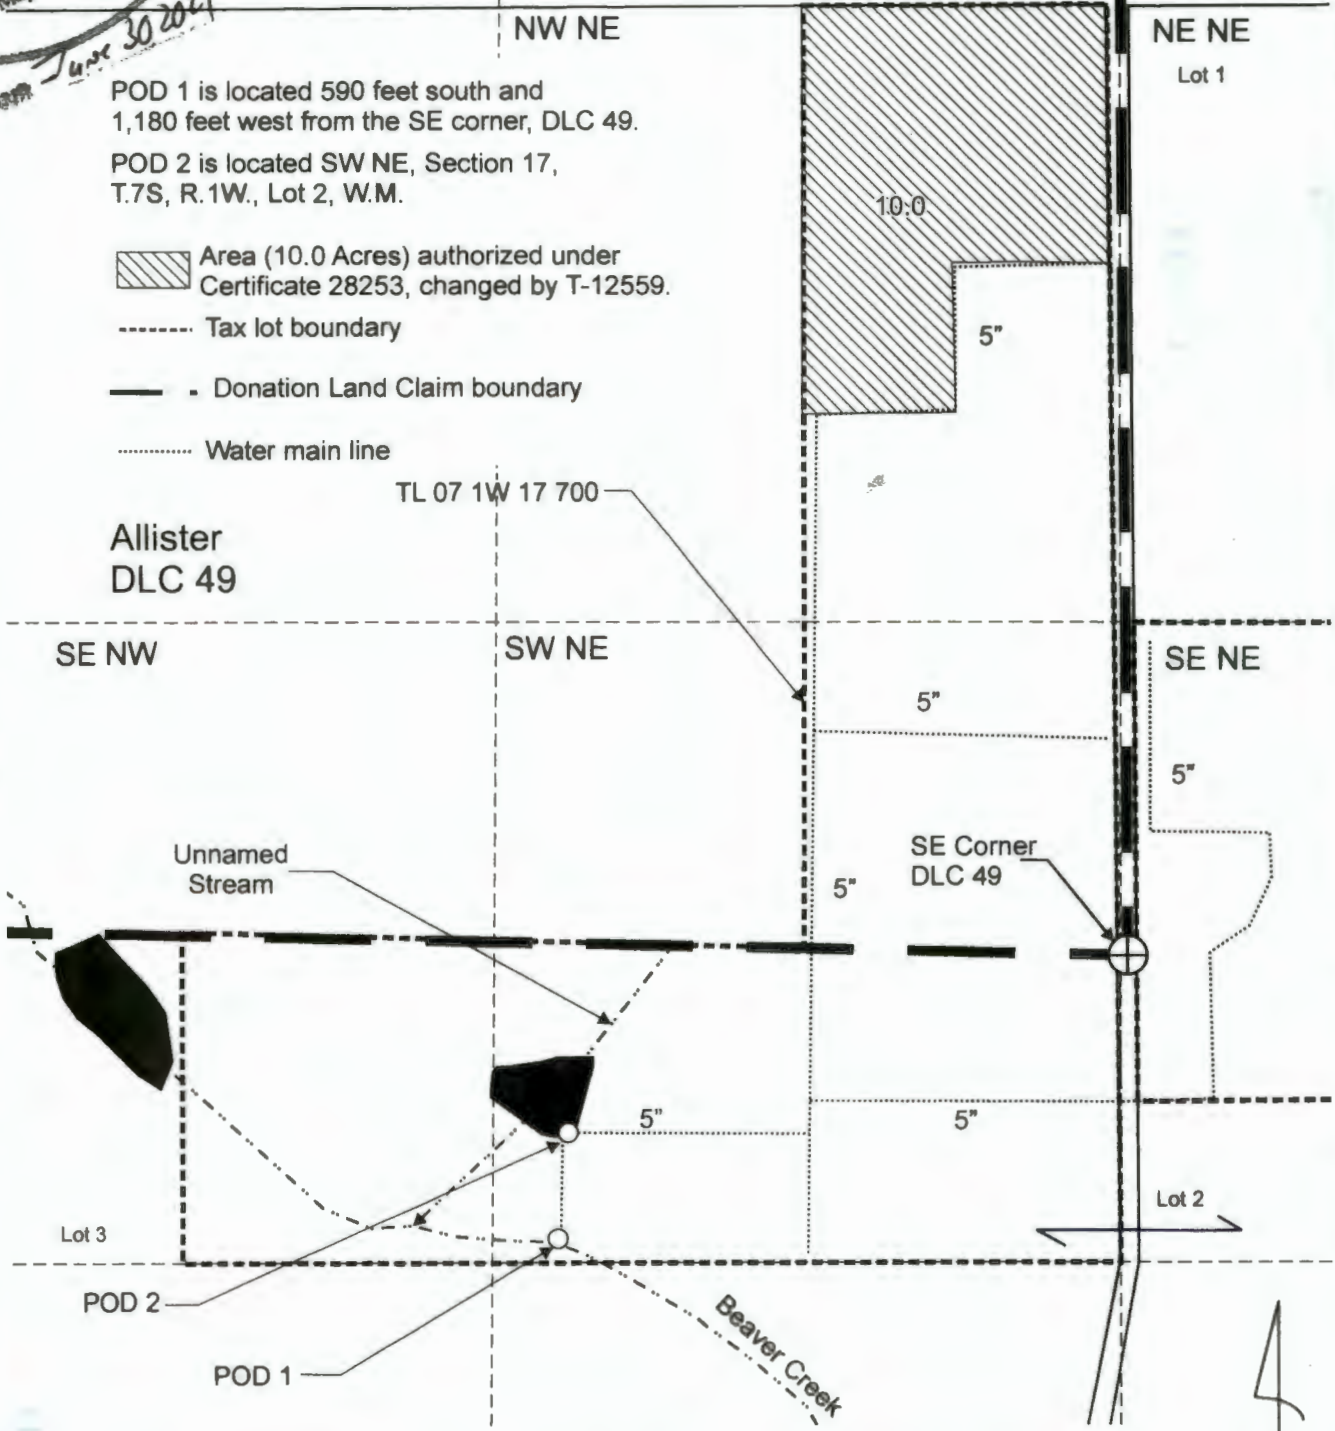

Scale: 1" = 400'

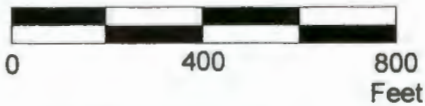

This map was prepared for the purpose of identifying the location of a water right only and is not intended to provide legal dimensions or location of property ownership lines.

**Claim of Beneficial Use
T-12559, Certificate 28253**

Bryan and Amy Schurter
T.7S. R.1W. Section 17, W.M.

Pacific Hydro-Geology Inc.

11/2019

SchurterGWAppMap.cdr