

RECEIVED
SEP 30 2020
OWRD

CLAIM OF BENEFICIAL USE MAP
CHANGE IN POD TO POA
Located in Sections 3, 4, 8, 9, 17, 18, and 20,
Township 14 South, Range 12 East, Willamette Meridian
Deschutes County, Oregon

NOTES

1. This map was prepared for the purpose of identifying the location of water rights only and is not intended to provide legal dimensions or locations of property ownership lines.
2. Tax lot lines are based on Deschutes County Assessor Maps dated Feb. 2, 2010.
3. Acres irrigated are identified in each 1/4-1/4 by total acres and by Tax Lot.
4. Place of Use and Character of Use Are not Changed.

Locations Of Points of Appropriation Established Through Transfer T-12651

- POA 1 - Well #1**
1880.6 Ft West and 1154.2 Ft North from the SE Corner of Section 18.
- POA 2 - Well #3**
1706.6 Ft West and 1772.1 Ft South from the NE Corner of Section 17.
- POA 3 - Well #4**
32.2 Ft East and 240.7 Ft South from the NW Corner of Section 17.
- POA 4 - Well #7**
2862.6 Ft West and 1571.4 Ft South from the NE Corner of Section 9.


DATE	
REVISION	
NO.	1
DATE	09/24/20
DRAWING STATUS	COBU MAP

LEGEND

- Primary Certificate 88027, Permit 32049 (307.8 Ac Total) Irrigation: April 13, 1967
- Supplemental Certificate 88027, Permit 32049 (12.6 Ac Total) Irrigation: April 13, 1967
- Primary Certificate 76371, Permit 32049 (157.1 Ac Total) Irrigation: April 13, 1967
- Supplemental Certificate 87655, Permit 32049 (206.6 Ac Total) Irrigation: Oct. 23, 1973
- Tax Lot Boundary Line
- Tax Lot ID Number
- Total Number of Acres Irrigated in 1/4-1/4




Certified Water Rights Examiner
419 WRE
David J. Newton
DAVID J. NEWTON
JAN. 16, 1998
STATE OF OREGON
EXPIRES: 31 DEC 2020
RENEWS: 31 DEC 2020

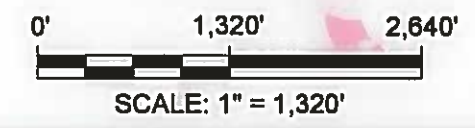

Quarter-Quarter Section Identifiers

5	4	4	3
8	9	9	10
NW-NW	NE-NW	NW-NE	NE-NE
SW-NW	SE-NW	SW-NE	SE-NE
NW-SW	NE-SW	NW-SE	NE-SE
SW-SW	SE-SW	SW-SE	SE-SE
8	9	9	10
17	16	16	15

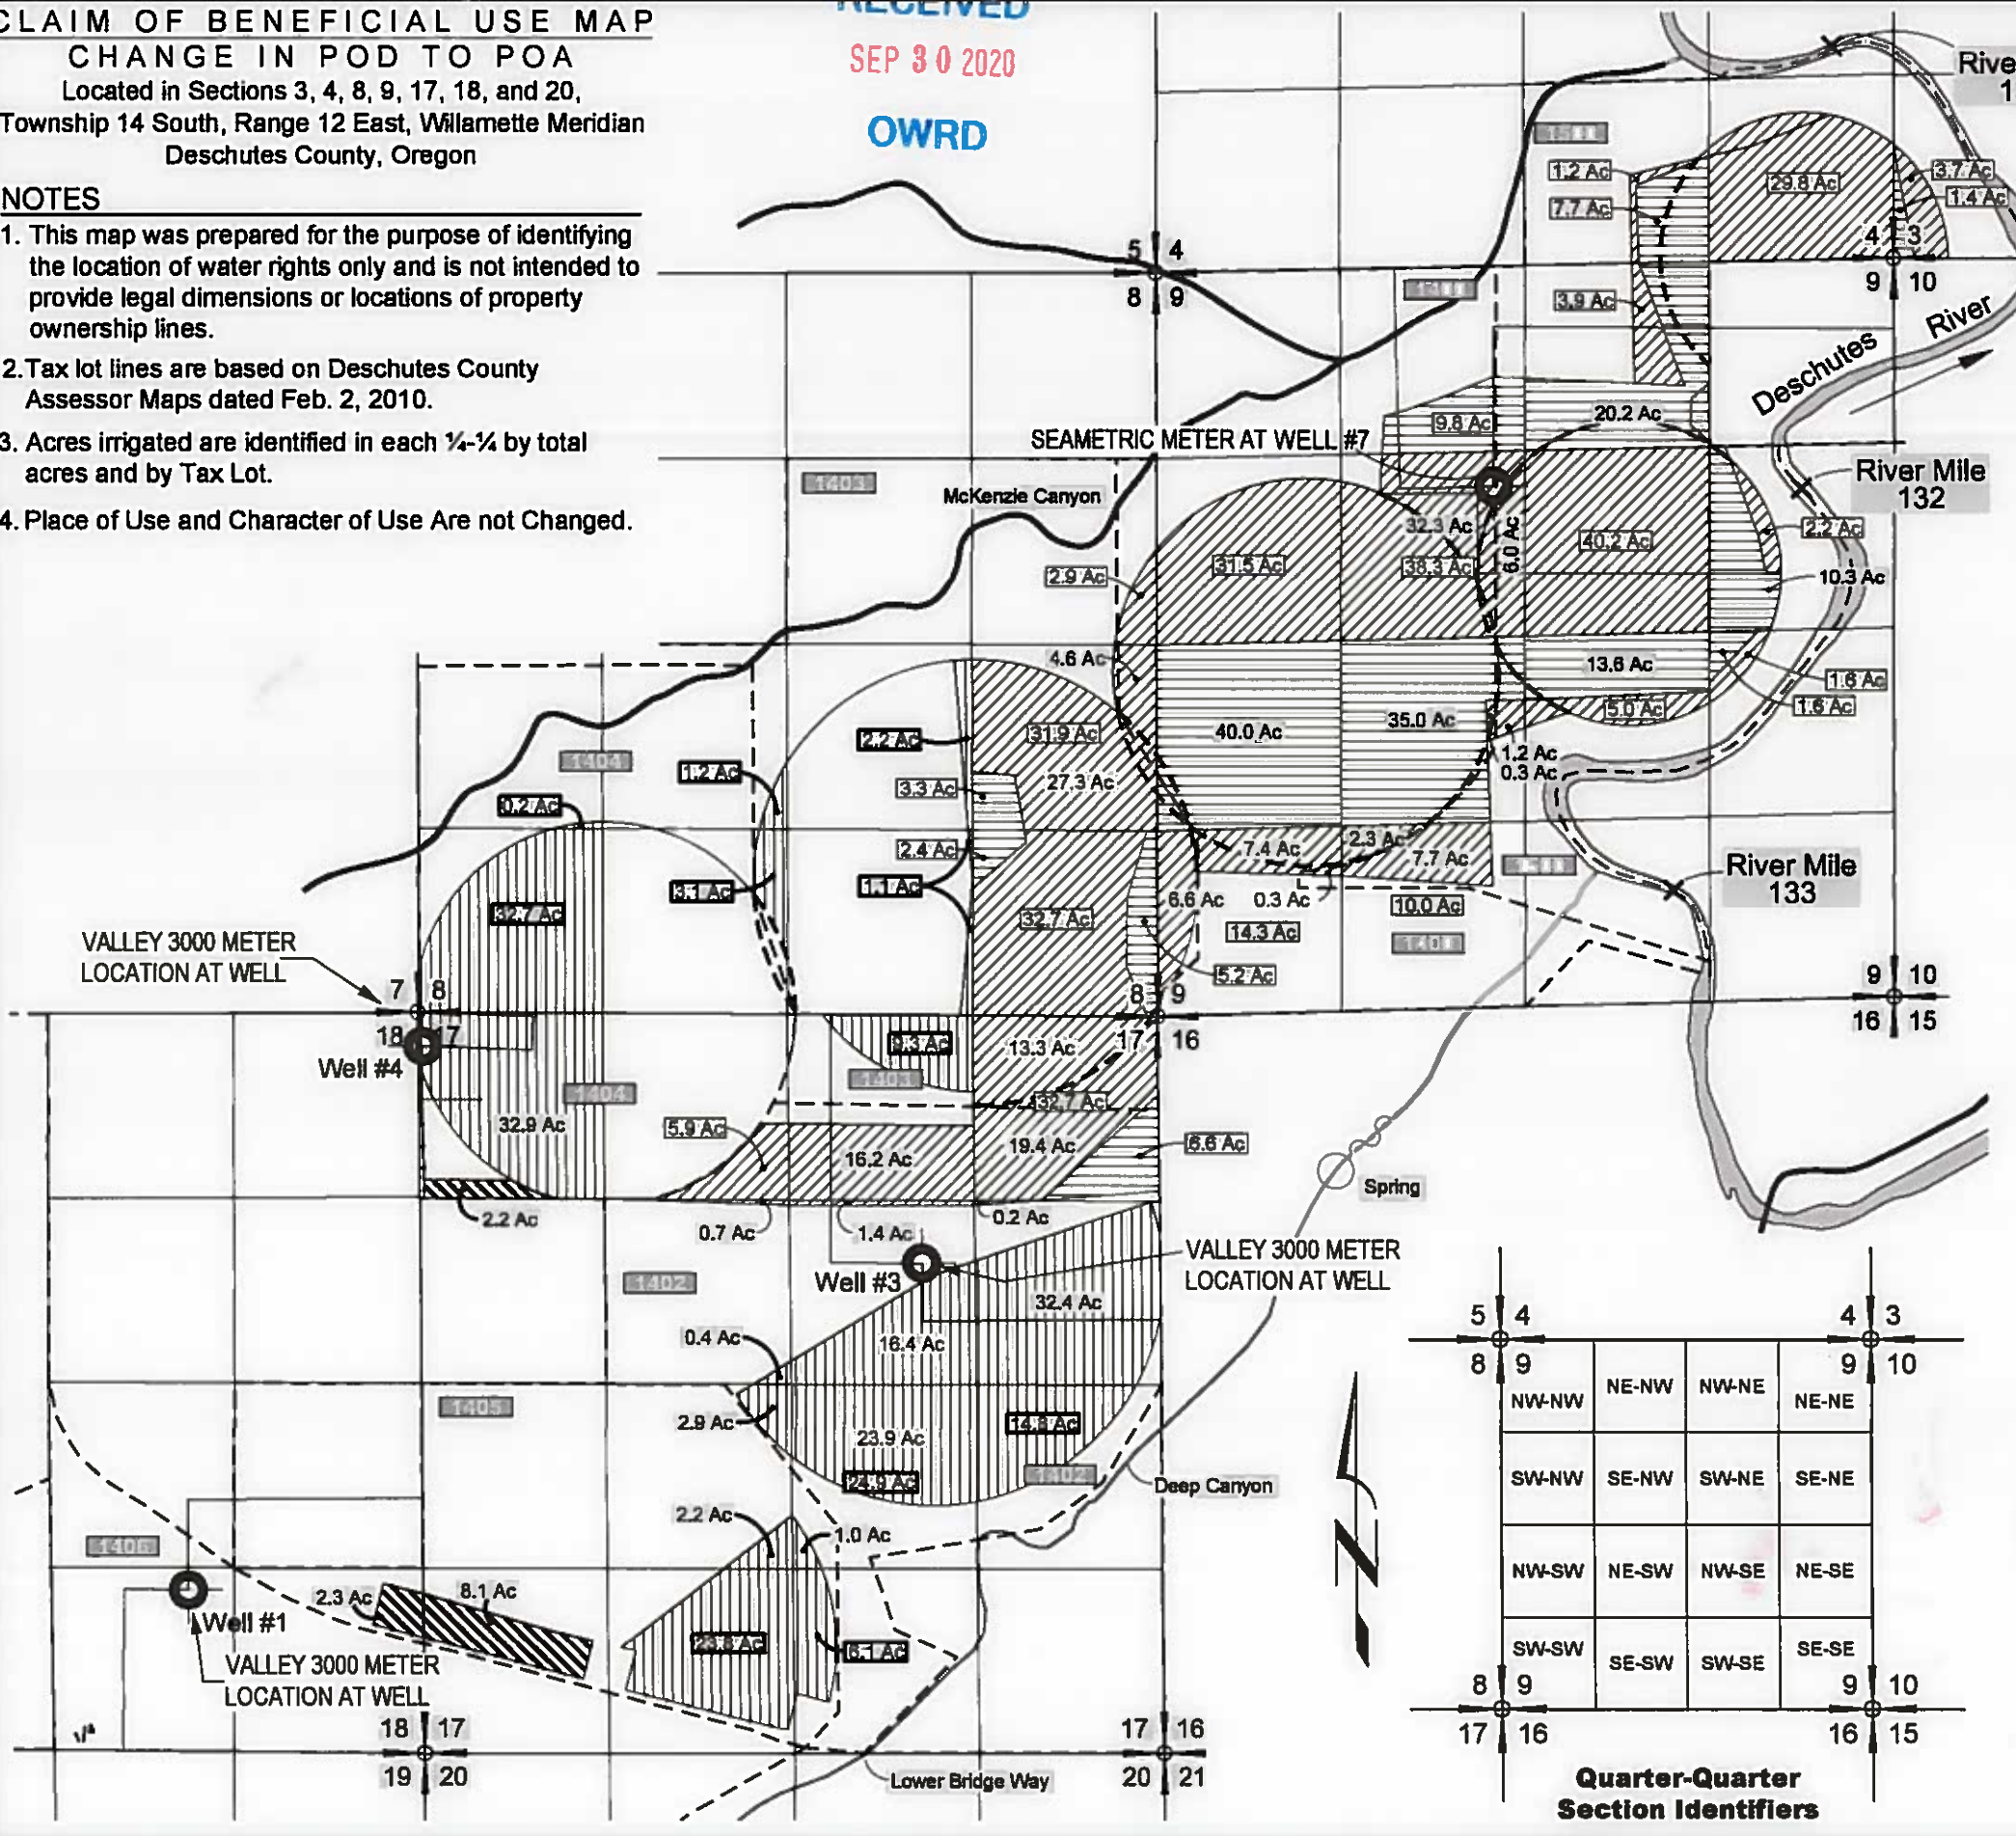

PROJECT: CLAIM OF BENEFICIAL USE MAP
SURFACE WATER POD TO GROUNDWATER
POA. TRANSFER T-12651

PROJECT LOCATION: DESCHUTES COUNTY, OR

CLIENT: BIG FALLS RANCH CO.

SHEET TITLE:
COBU MAP
TRANSFER T-12651

JOB NO. 556-103
DRAWN BY: SS / BPL
DRAWING: 1