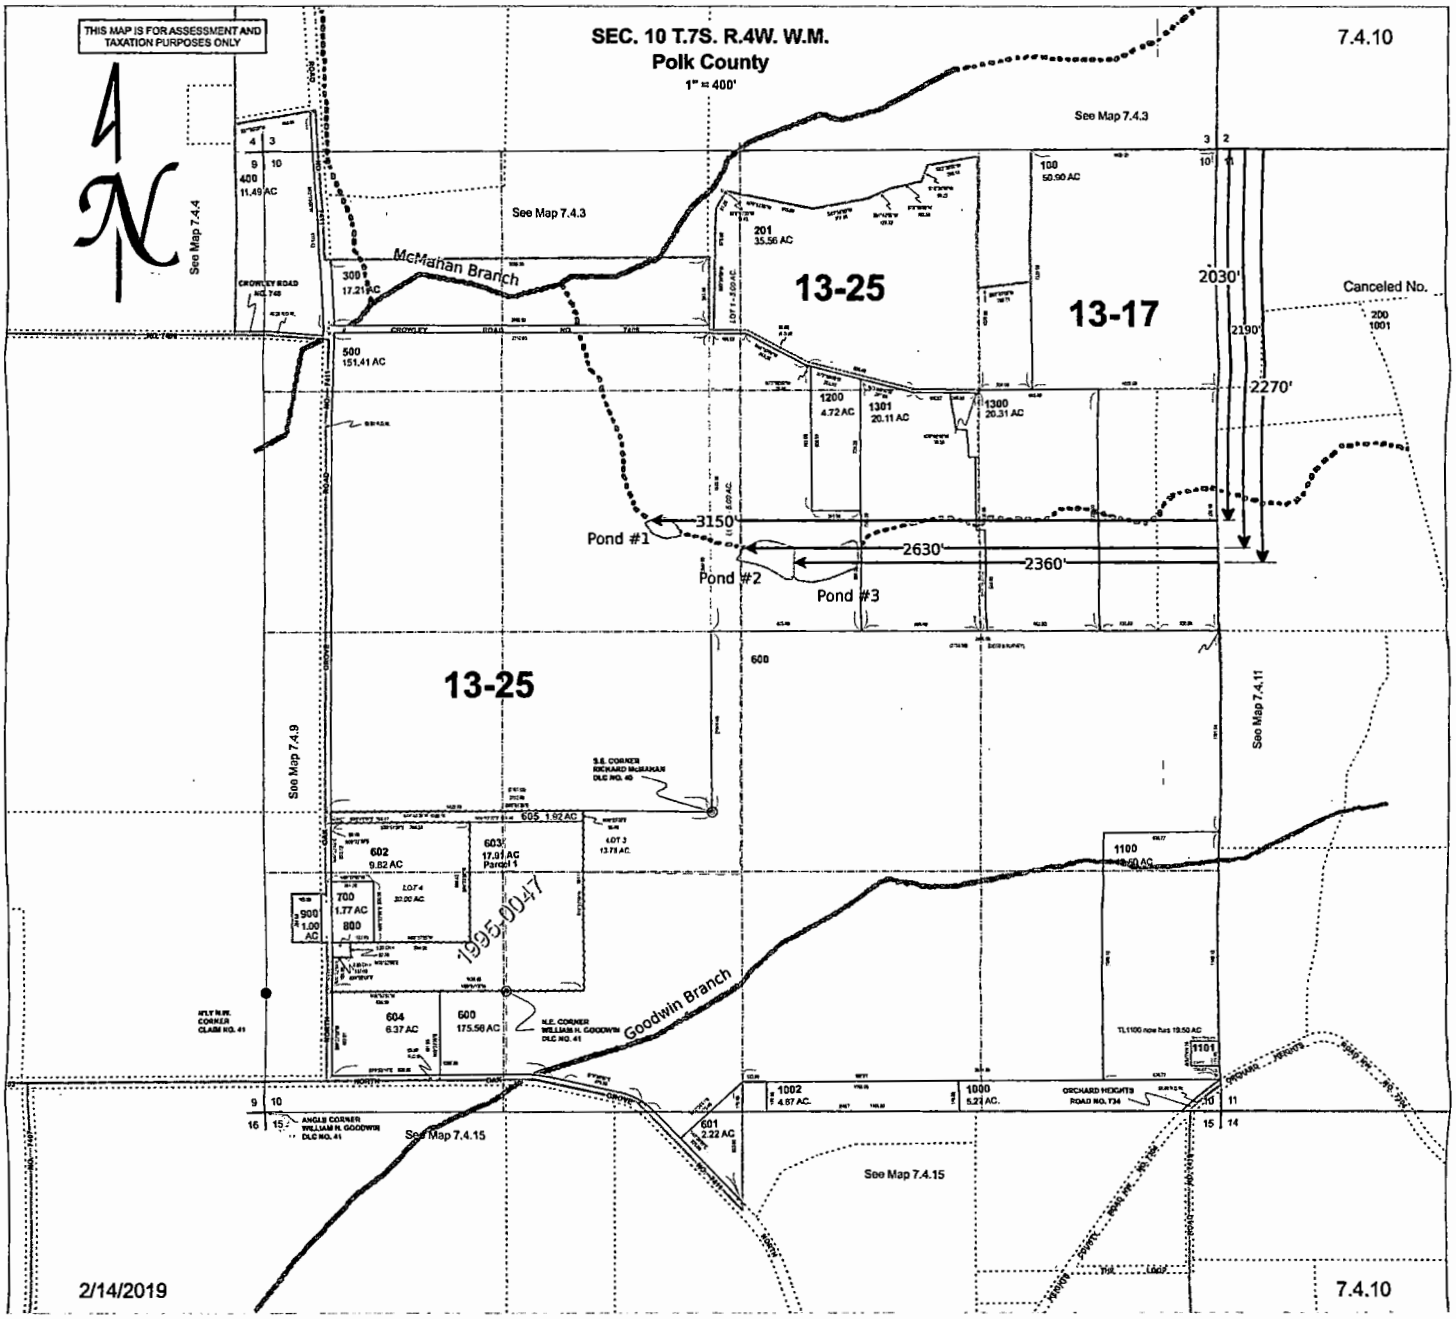RECEIVED
OCT 12 2021
OWRD