


T. 13 S., R. 17 E., W. M.

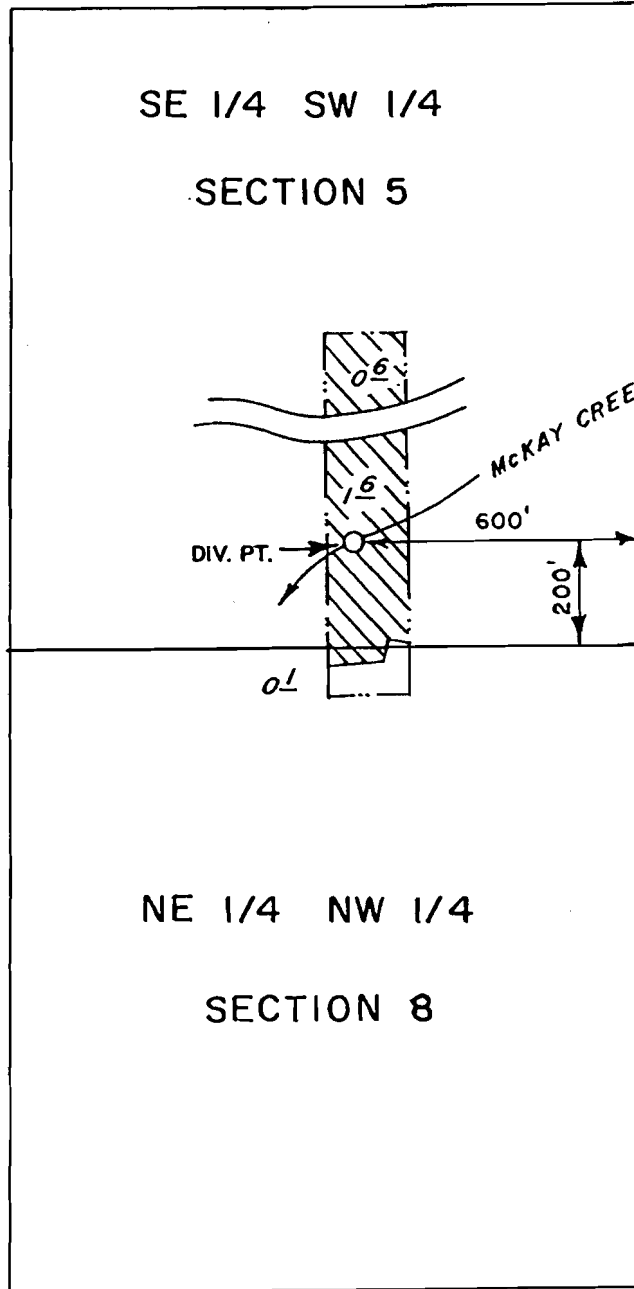

SCALE 1" = 400'

FINAL PROOF SURVEY
UNDER

Application No. 60242 Permit No. 45561
IN NAME OF

JOSEPH EDMONDS

Surveyed NOV. 12, 1998, by STEVE BROWN

C 76017
T 8642

45561