


Map of J. L. Howard's Irrigable Land.  
 On Willow Creek Morrow County Oregon.

I, D. V. F. Reid, hereby certify that this map was made from notes of an actual survey made by me on August 30-1909, and that it shows the number of acres of irrigable land in each smallest legal subdivision described to be irrigated from the Ditch herein represented

D. V. F. Reid  
 Surveyor

Scale 4 ch to 1 inch.

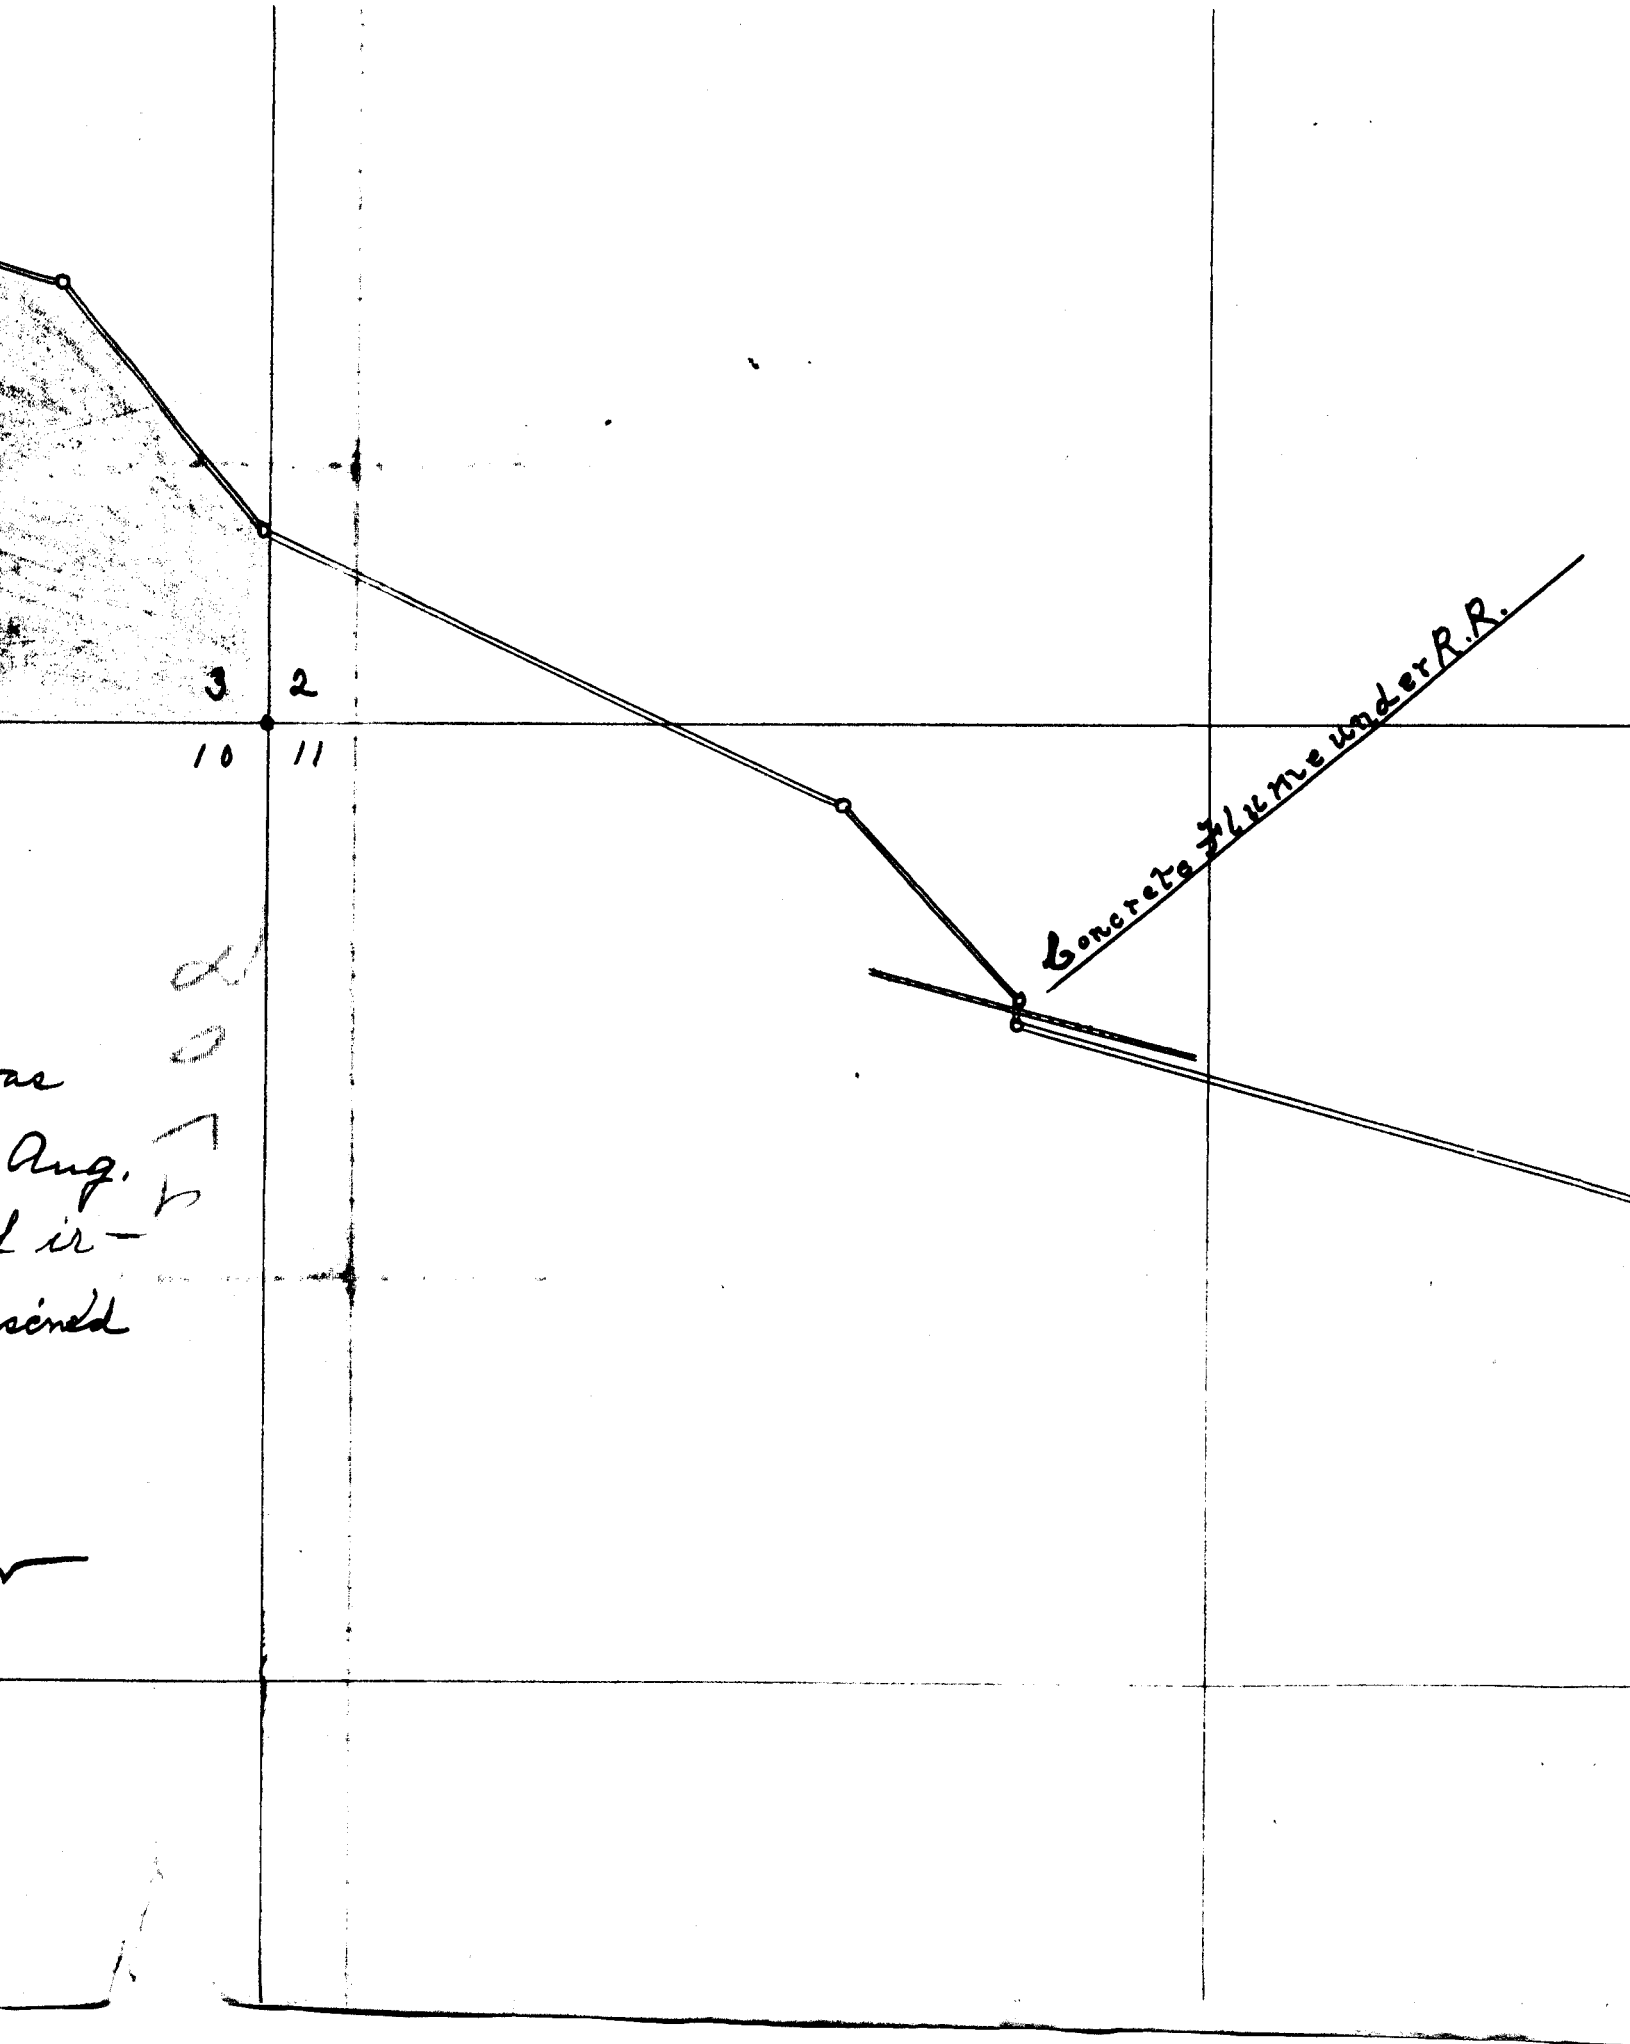

R.

Ditch

N.E. Cor. Sec. 11, T<sub>4</sub>S, R. 24E, N.M.

Point of Division of water  
North 16<sup>th</sup> Tp 18 R 24 E N.M.  
Section corner for N.W. 1/4

Ditch

Willow Creek