


FOR: YVAN LEBEL
BY: NATHAN R. REED, PE, CWRE
T28S, R5W, W.M. SECTION 22
APPLICATION NO.: S-87178
PERMIT NO.: S-54543

Scale: 1" = 400'

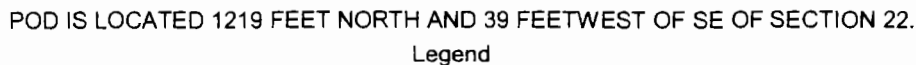

	Stream		Water Tank		Structure		Sixteenth
	POD		Meter		Flow arrow		Parcels
	Pipeline		Roads		Section		

MAP PREPARED BY:
NATHAN R. REED, PE, CWRE
157 WEST BODIE STREET
ROSEBURG, OR 97471