

CLAIM OF BENEFICIAL USE MAP
 T.38 S. R.05 W. SEC. 27 W.M.


UNDER:
 APPLICATION G-13507
 PERMIT No. G-12635

IN NAME OF:
 RICHARD and JOANN WORTH

WELL IS LOCATED
 985 FEET NORTH &
 720 FEET WEST FROM
 SOUTH 1/4 CORNER
 FOR SECTION 27

CROSS HATCHURE
 SHOWS IRRIGATED
 ACREAGE

DASHED LINE
 SHOWS BURIED
 1" AND 2"
 PVC PIPE

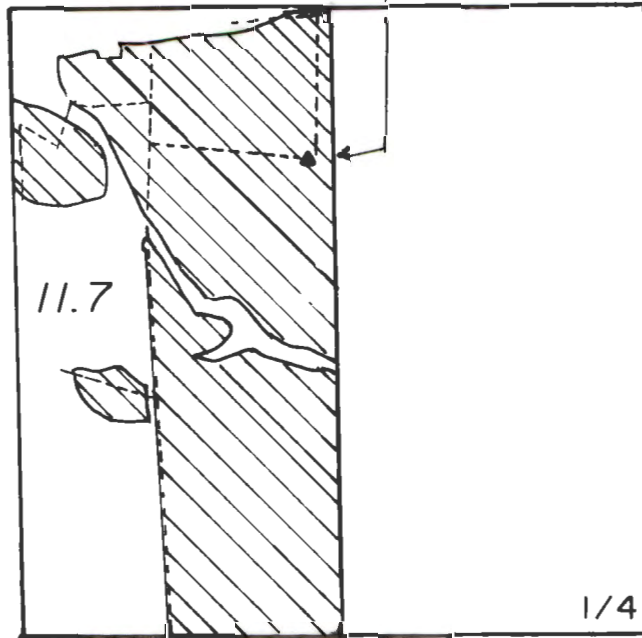

SCALE: 1" = 400'

W 1/2, SE 1/4, SW 1/4
 OF SECTION 27


34

27

FOUND IRON PIPE
 W/ BRASS CAP PER
 JOSEPHINE COUNTY
 SURVEYOR'S PROPORTIONED
 CORNER BK. 50 P. 68

SURVEYED SEPTEMBER 24, 2001 BY:

JONATHAN C. SPERO C.W.R.E. 123
 1002 KINCAID RD./P.O. BOX 16
 WILLIAMS, OREGON 97544
 PH. (541) 846-6845

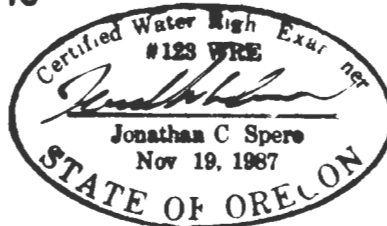

LICENSE RENEWAL DATE:
 JUNE 30, 2002

RECEIVED

OCT 01 2001

WATER RESOURCES DEPT.
 SALEM, OREGON

THIS MAP IS FOR THE PURPOSE OF
 IDENTIFYING THE LOCATION OF THE
 WATER RIGHT ONLY, AND IS NOT IN-
 TENDED TO PROVIDE LEGAL DIMEN-
 SIONS OR LOCATIONS OF PROPERTY
 OWNERSHIP LINES.