

RECEIVED BY OWRD


CLAIM OF BENEFICIAL USE

DEC 29 2016

APPLICATION R-73305
APPLICATION S-73306

PERMIT R-11616
PERMIT S-51856

SECTION 12, TOWNSHIP 29 SOUTH, RANGE 15 WEST, W.M.
COOS COUNTY OREGON

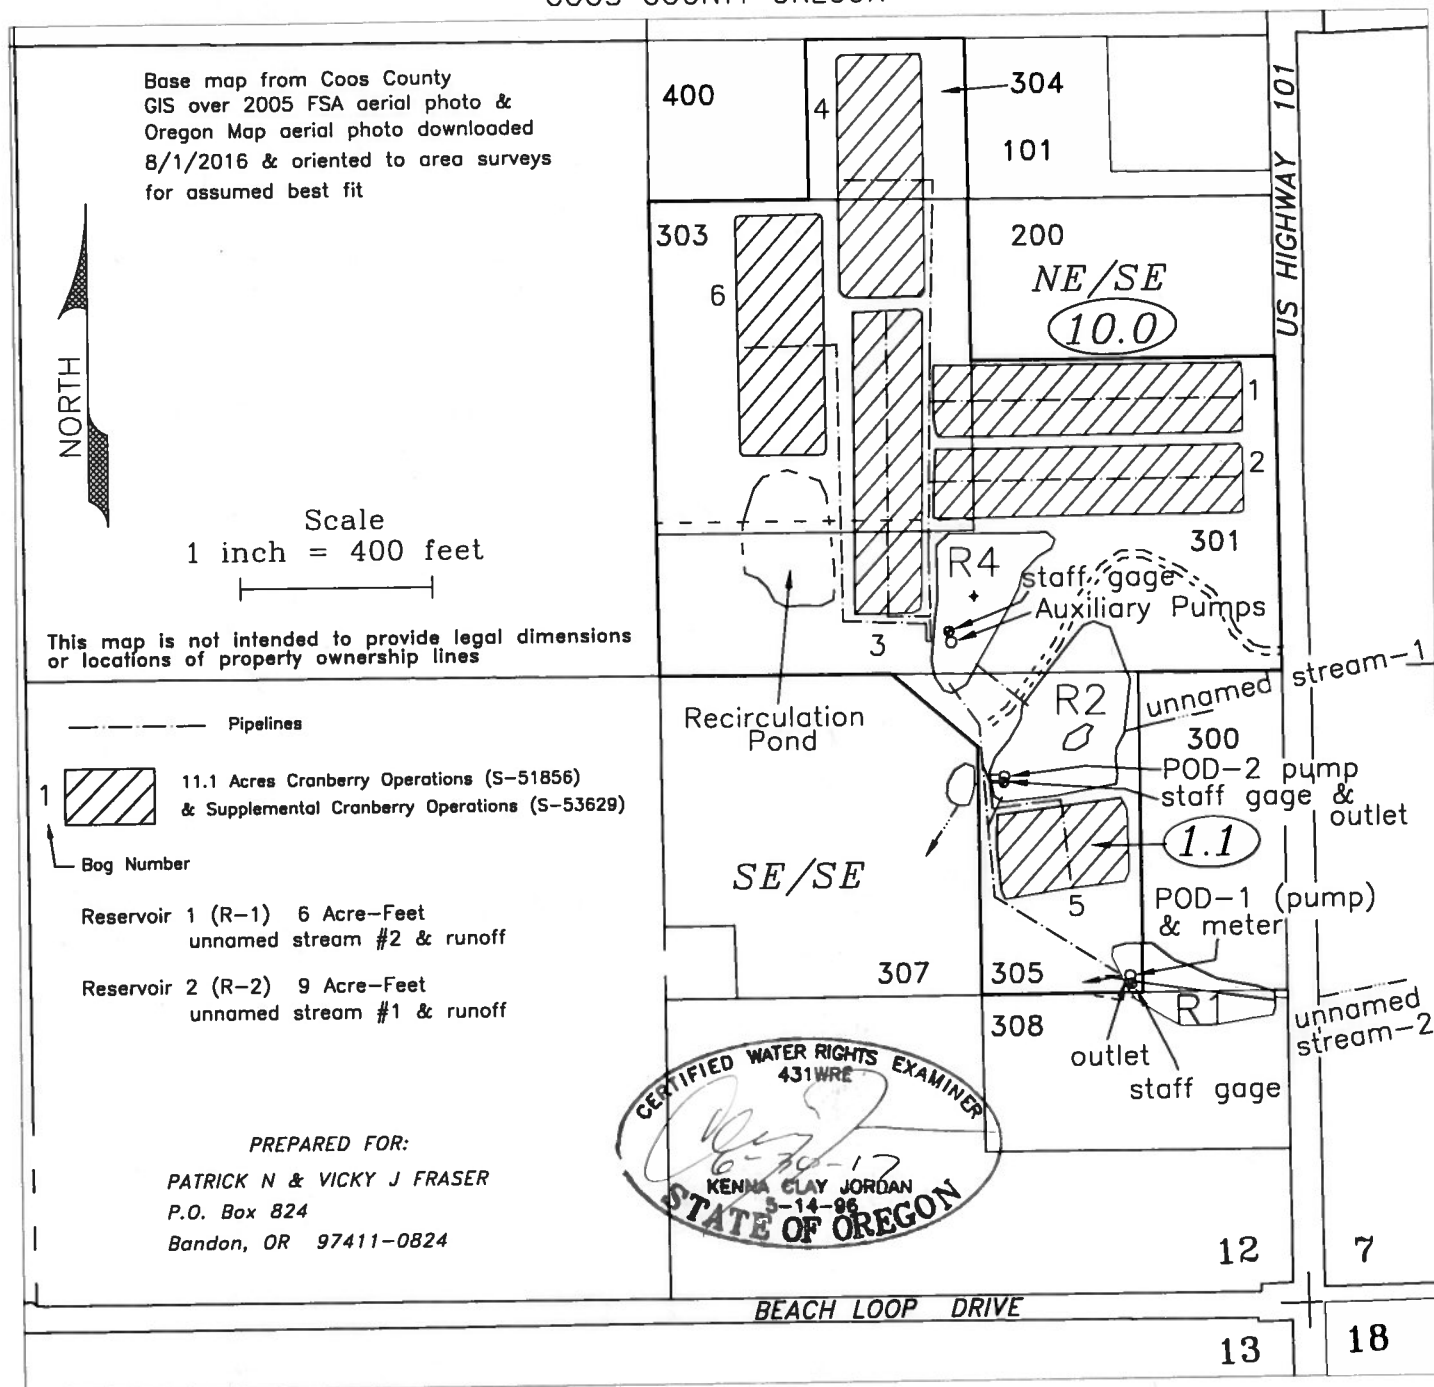

POINTS OF DIVERSION

(All from the SE Corner of Section 12)

Reservoir 1 outlet and POD-1, SE/SE, 690 ft. North & 370 ft. West - POD-1 delivers water from unnamed stream #2 and Reservoir 1 to Reservoir 2 and Reservoir 4 for distribution to bogs from POD 2 & 3

Reservoir 2 outlet and POD-2, SE/SE, 1100 ft. North & 620 ft. West - POD-2 delivers water from unnamed stream #1 & Reservoir 2 to bog 5 and Reservoir 4 for distribution to bogs 1, 2, 3, 4 & 6 from POD-3

Auxiliary pumps in R-4 (bulge) deliver water to bogs 1, 2, 3, 4, 6

JORDAN ENGINEERING
460 JORDAN LANE
ROSEBURG, OR 97471
(541) 673-1931

5/6/2010 n.e.d.
Revised 9/19/2016 n.e.d.