


# Oak Grove Water Company

## Claim of Beneficial Use Map

T.2N., R.10E., W.M.

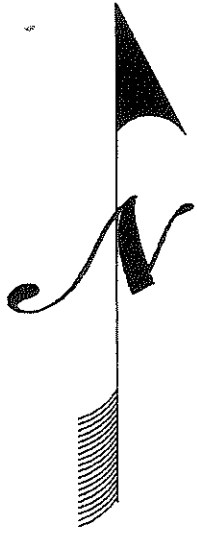


Application # S-73940  
 Permit # 53679  
 Priority Date: 3/2/94  
 Today's Date: 9/18/2000  
 Drawing by: CAD




Surveyed Aug 11&12, 2000

Scale 1" = 1320'

Map Legend	
	Single Domestic
	2-D, 3-D, 4-D, etc, are the number of domestic rights within the building.
	Quarter/Quarter
	OGW pipeline
	County Road
	Ind. Industrial
	Restaurant
	6" Pipe size


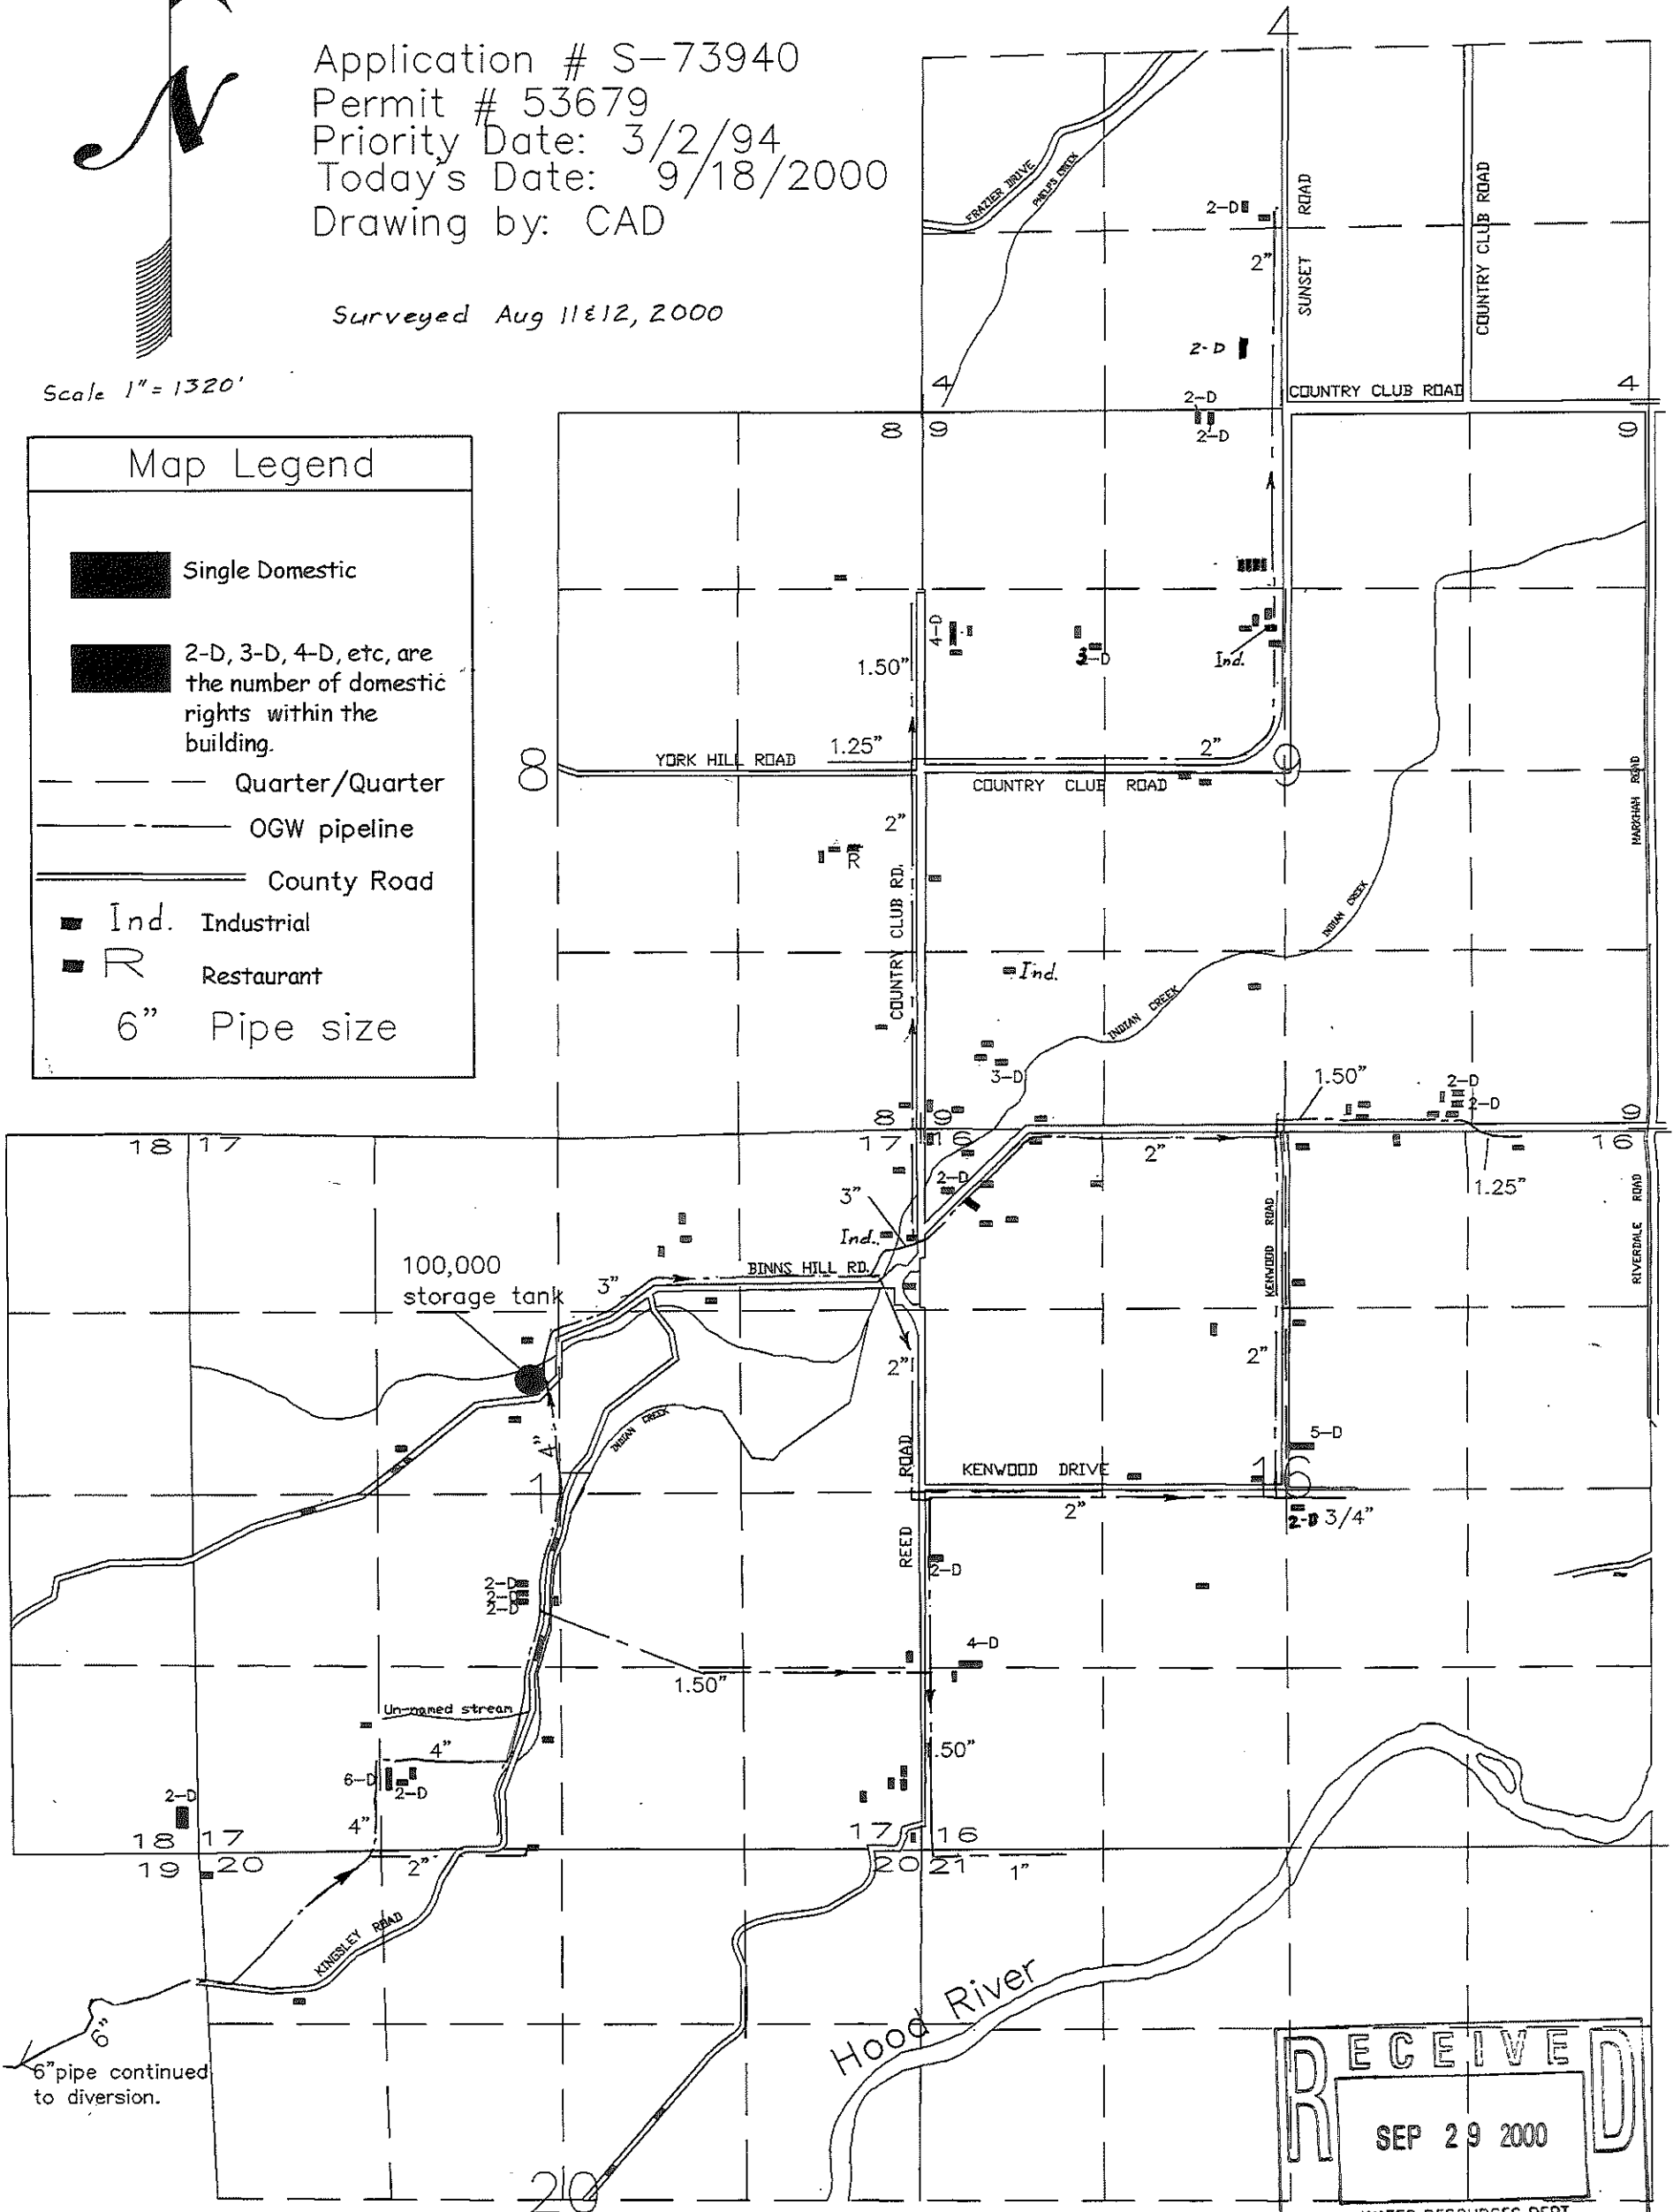


6" pipe continued to diversion.

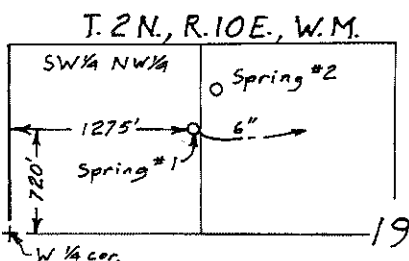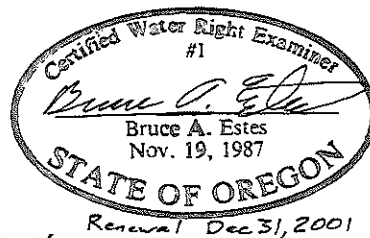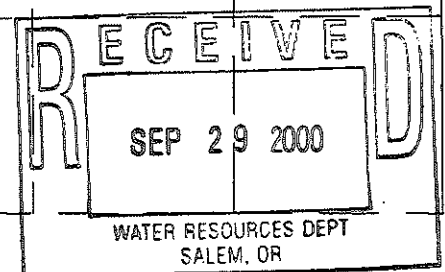

This map is for the purpose of locating a water right only and has no intent to provide legal dimensions or the location of property lines.

**ESTES SURVEYS**  
 PO Box 17519 60382 Arnold Rd  
 Salem, OR 97305-7519 Bend, OR 97702  
 (503) 585-7593 (541) 382-7391

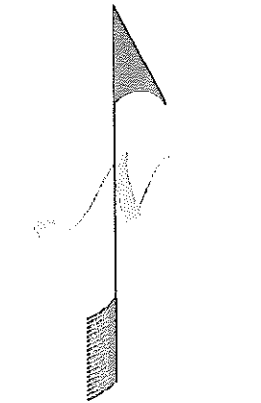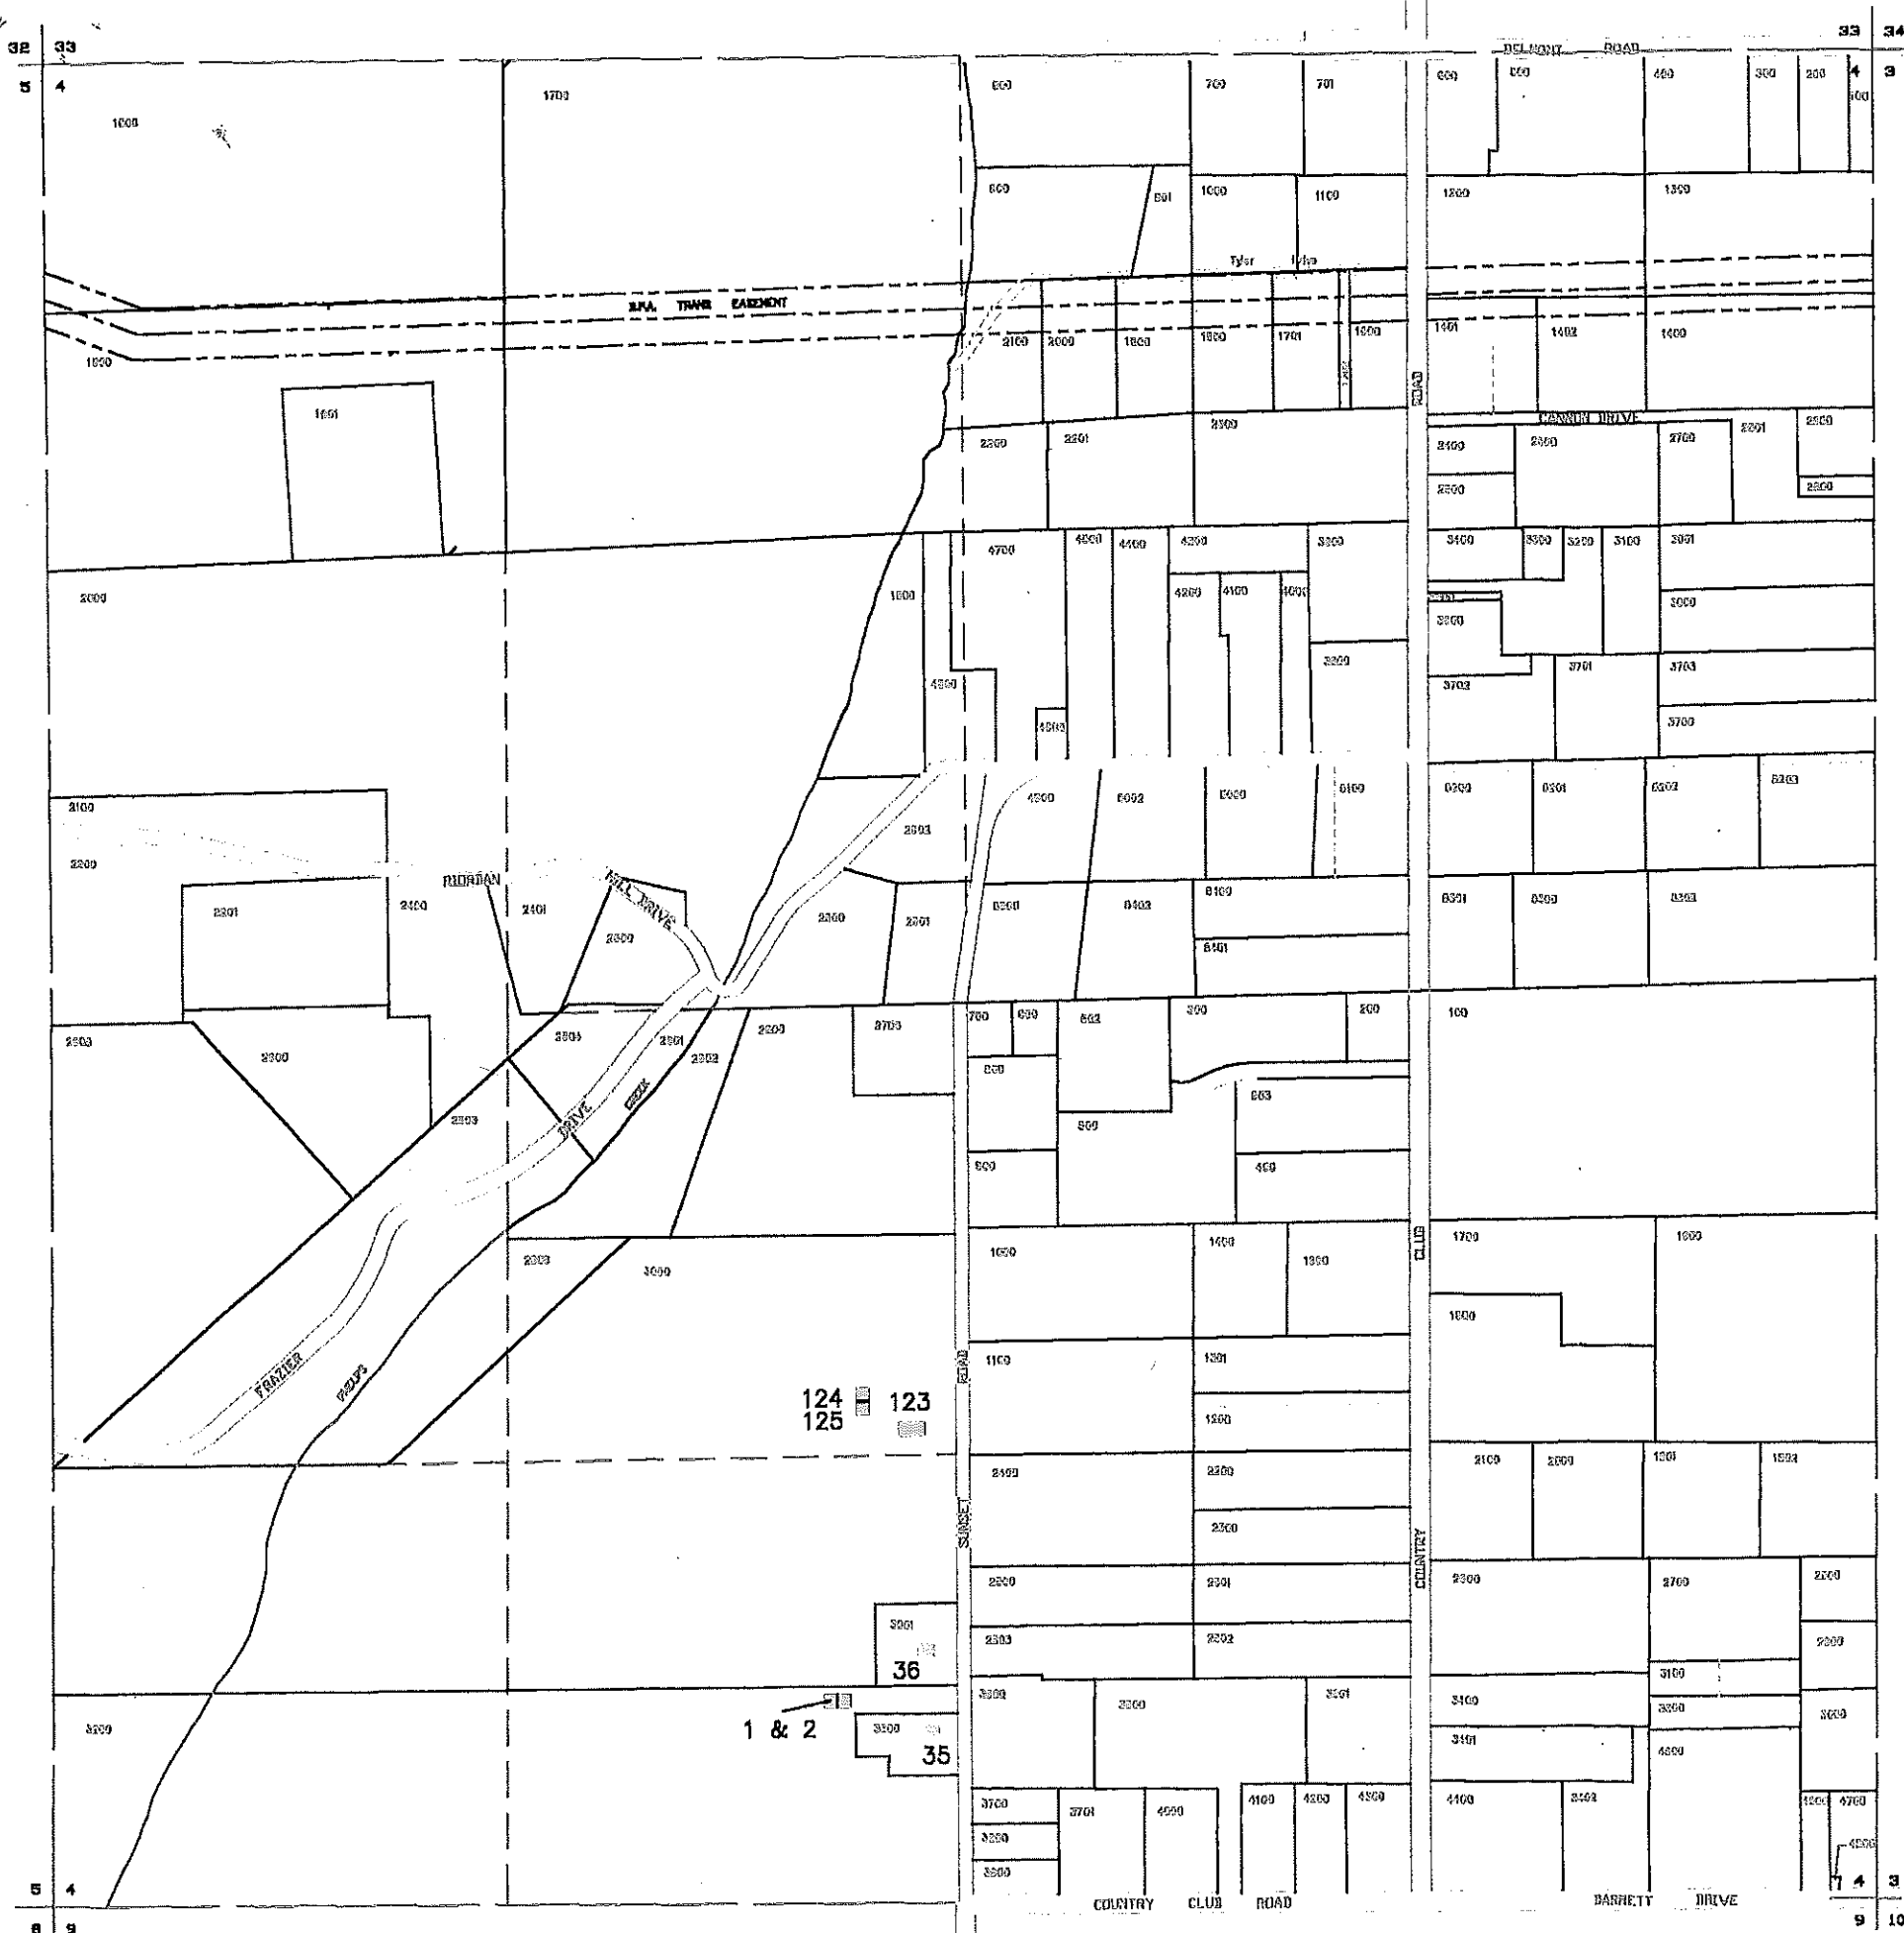

MAP SYMBOL LEGEND

- SECTION LINE
- PROPERTY LINE
- RIGHT OF WAY
- PRIVATE ROAD
- DLC LINE
- - - QTR-SECTION LINE EASEMENT
- RIVER
- CREEK
- - - B.P.A. EASEMENT
- PIPE

WATER RIGHT LEGEND


- Permit # 53679
- Certificate # 9151

OAK GROVE WATER COMPANY INC.  
HOOD RIVER OREGON

SECTION 4 T2N R10E  
REVISION DATE: September 1, 2000



SCALE: 1" = MAP 1 of 8

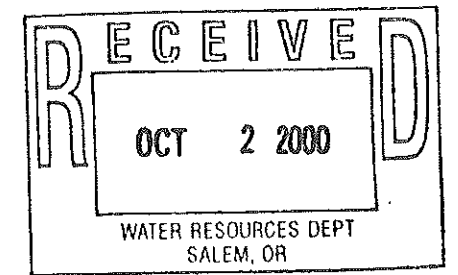



MAP SYMBOL LEGEND

- SECTION LINE
- PROPERTY LINE
- RIGHT OF WAY
- PRIVATE ROAD
- D.I.C. LINE
- SECTION LINE EASEMENT
- RIVER
- CREEK
- B.P.A. EASEMENT
- PIPE

WATER RIGHT LEGEND


- Permit # 53679
- Certificate # 9151


OAK GROVE WATER COMPANY INC.  
HOOD RIVER OREGON

SECTION 8 T2N R10E  
REVISION DATE: September 1, 2000



SCALE: 1" = MAP 2 of 8

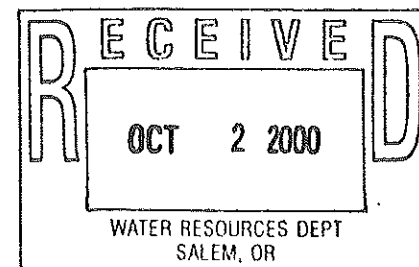

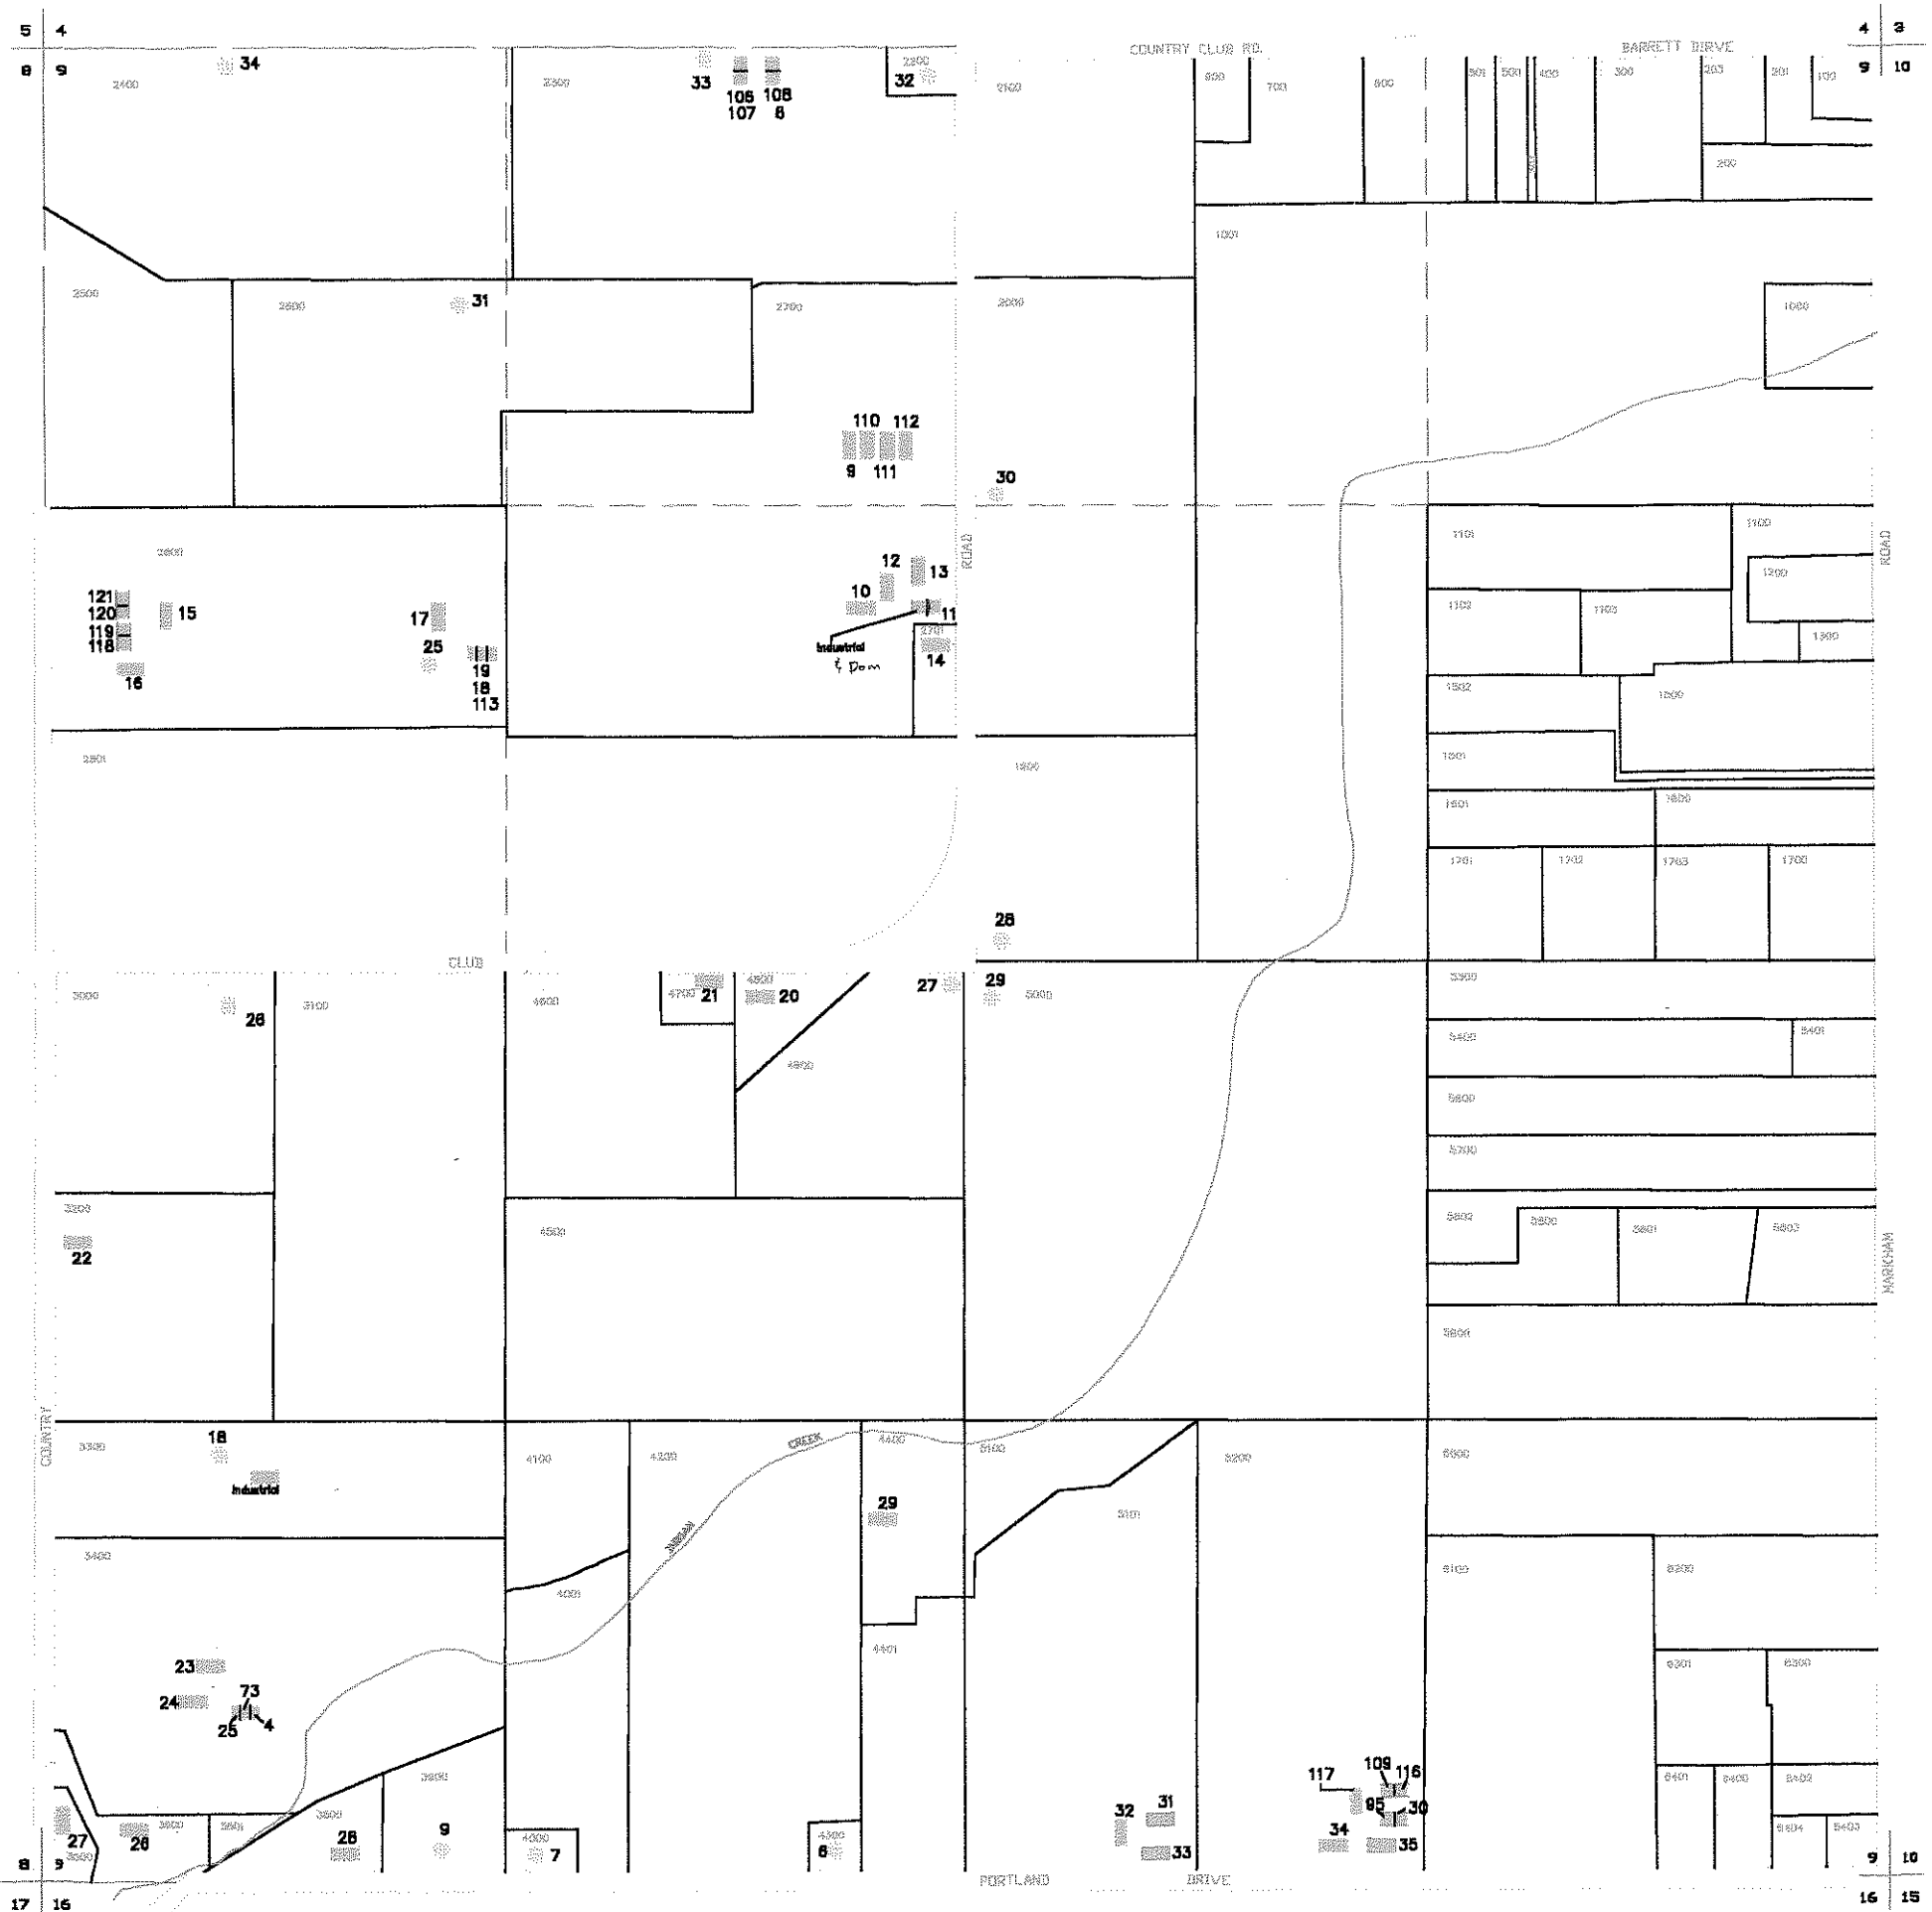

MAP SYMBOL LEGEND

- SECTION LINE
- PROPERTY LINE
- RIGHT OF WAY
- PRIVATE ROAD
- D.I.C. LINE
- EASEMENT
- RIVER
- CREEK
- B.P.A. EASEMENT
- PIPE

WATER RIGHT LEGEND


- Permit # 53679
- Certificate # 9151


OAK GROVE WATER COMPANY INC.  
HOOD RIVER OREGON

SECTION 9 T2N R10E  
REVISION DATE: September 1, 2000



SCALE: 1" = MAP 3 of 8

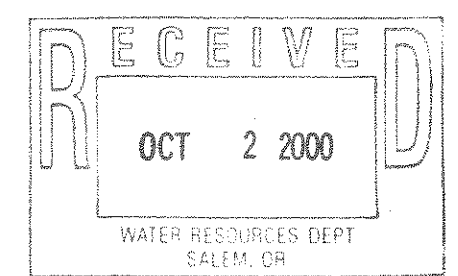

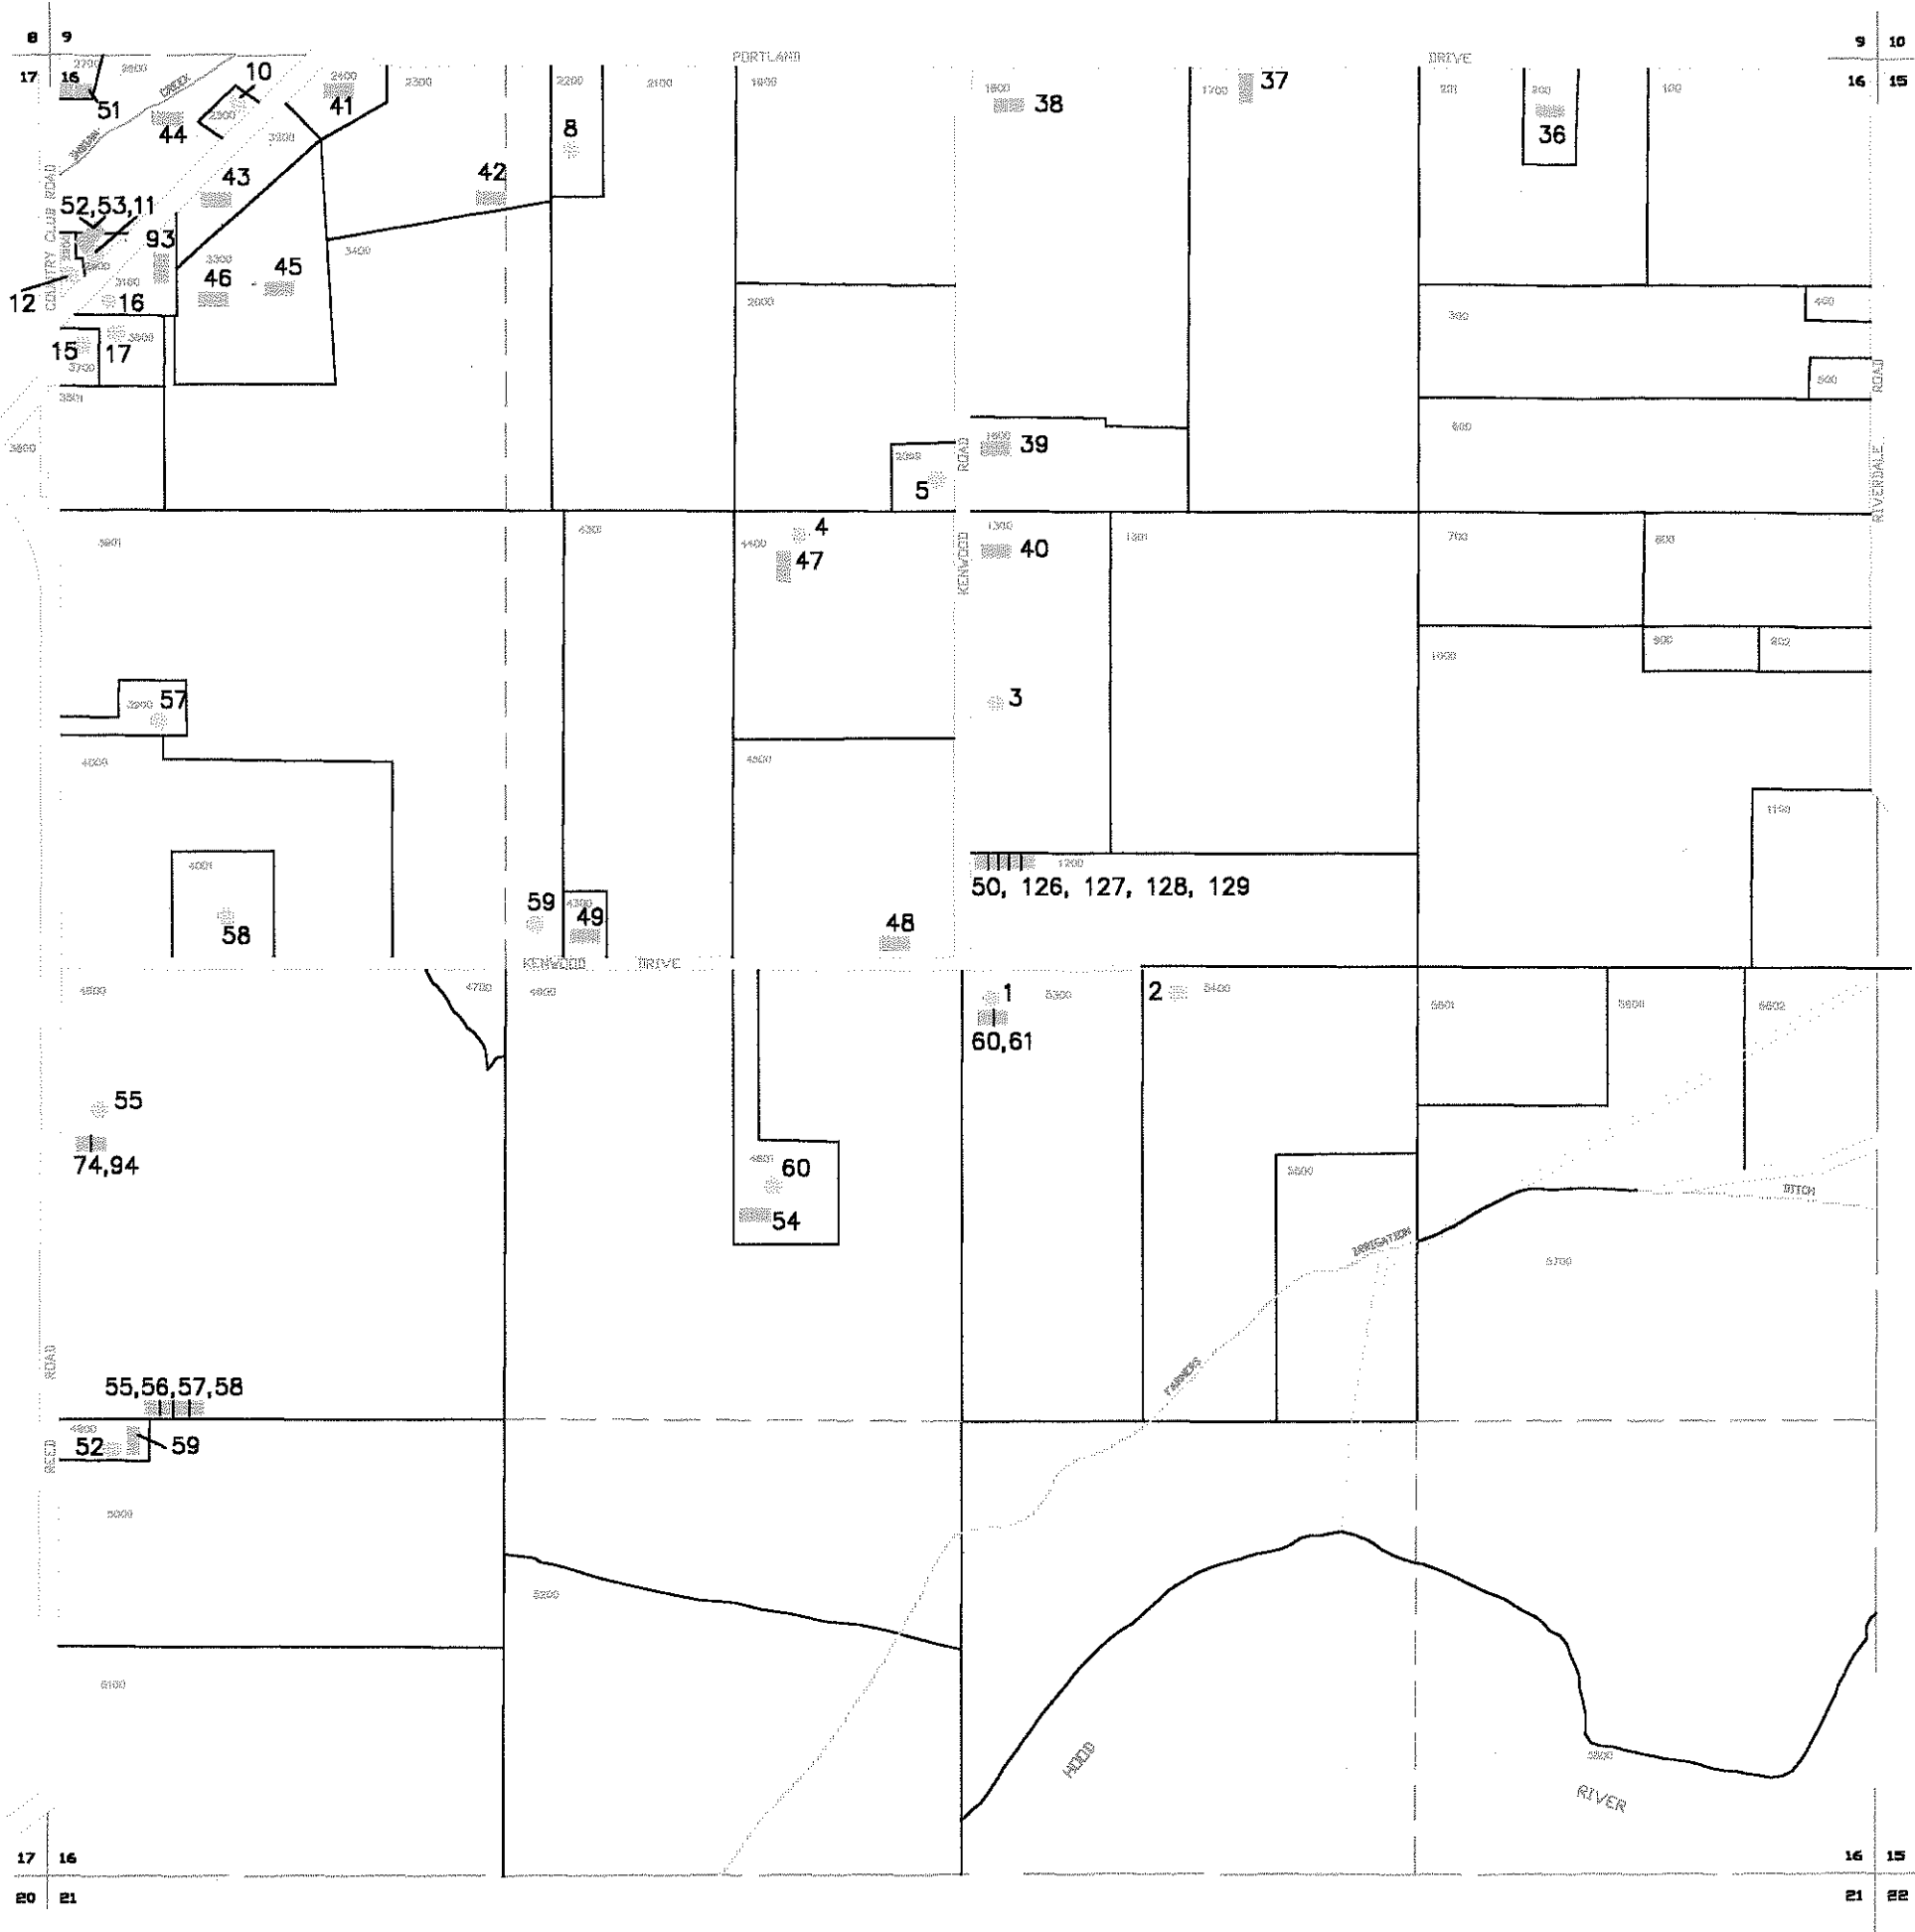

MAP SYMBOL LEGEND

- SECTION LINE
- PROPERTY LINE
- RIGHT OF WAY
- PRIVATE ROAD
- DLC LINE
- - - QTR-SECTION LINE
- EASEMENT
- RIVER
- CREEK
- - - B.P.A. EASEMENT PIPE

WATER RIGHT LEGEND


- Permit # 53679
- Certificate # 9151


OAK GROVE WATER COMPANY INC.  
HOOD RIVER OREGON

SECTION 16 T2N R10E  
REVISION DATE: September 1, 2000



SCALE: 1" = MAP 4 of 8

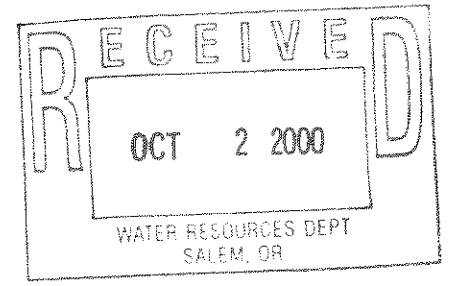

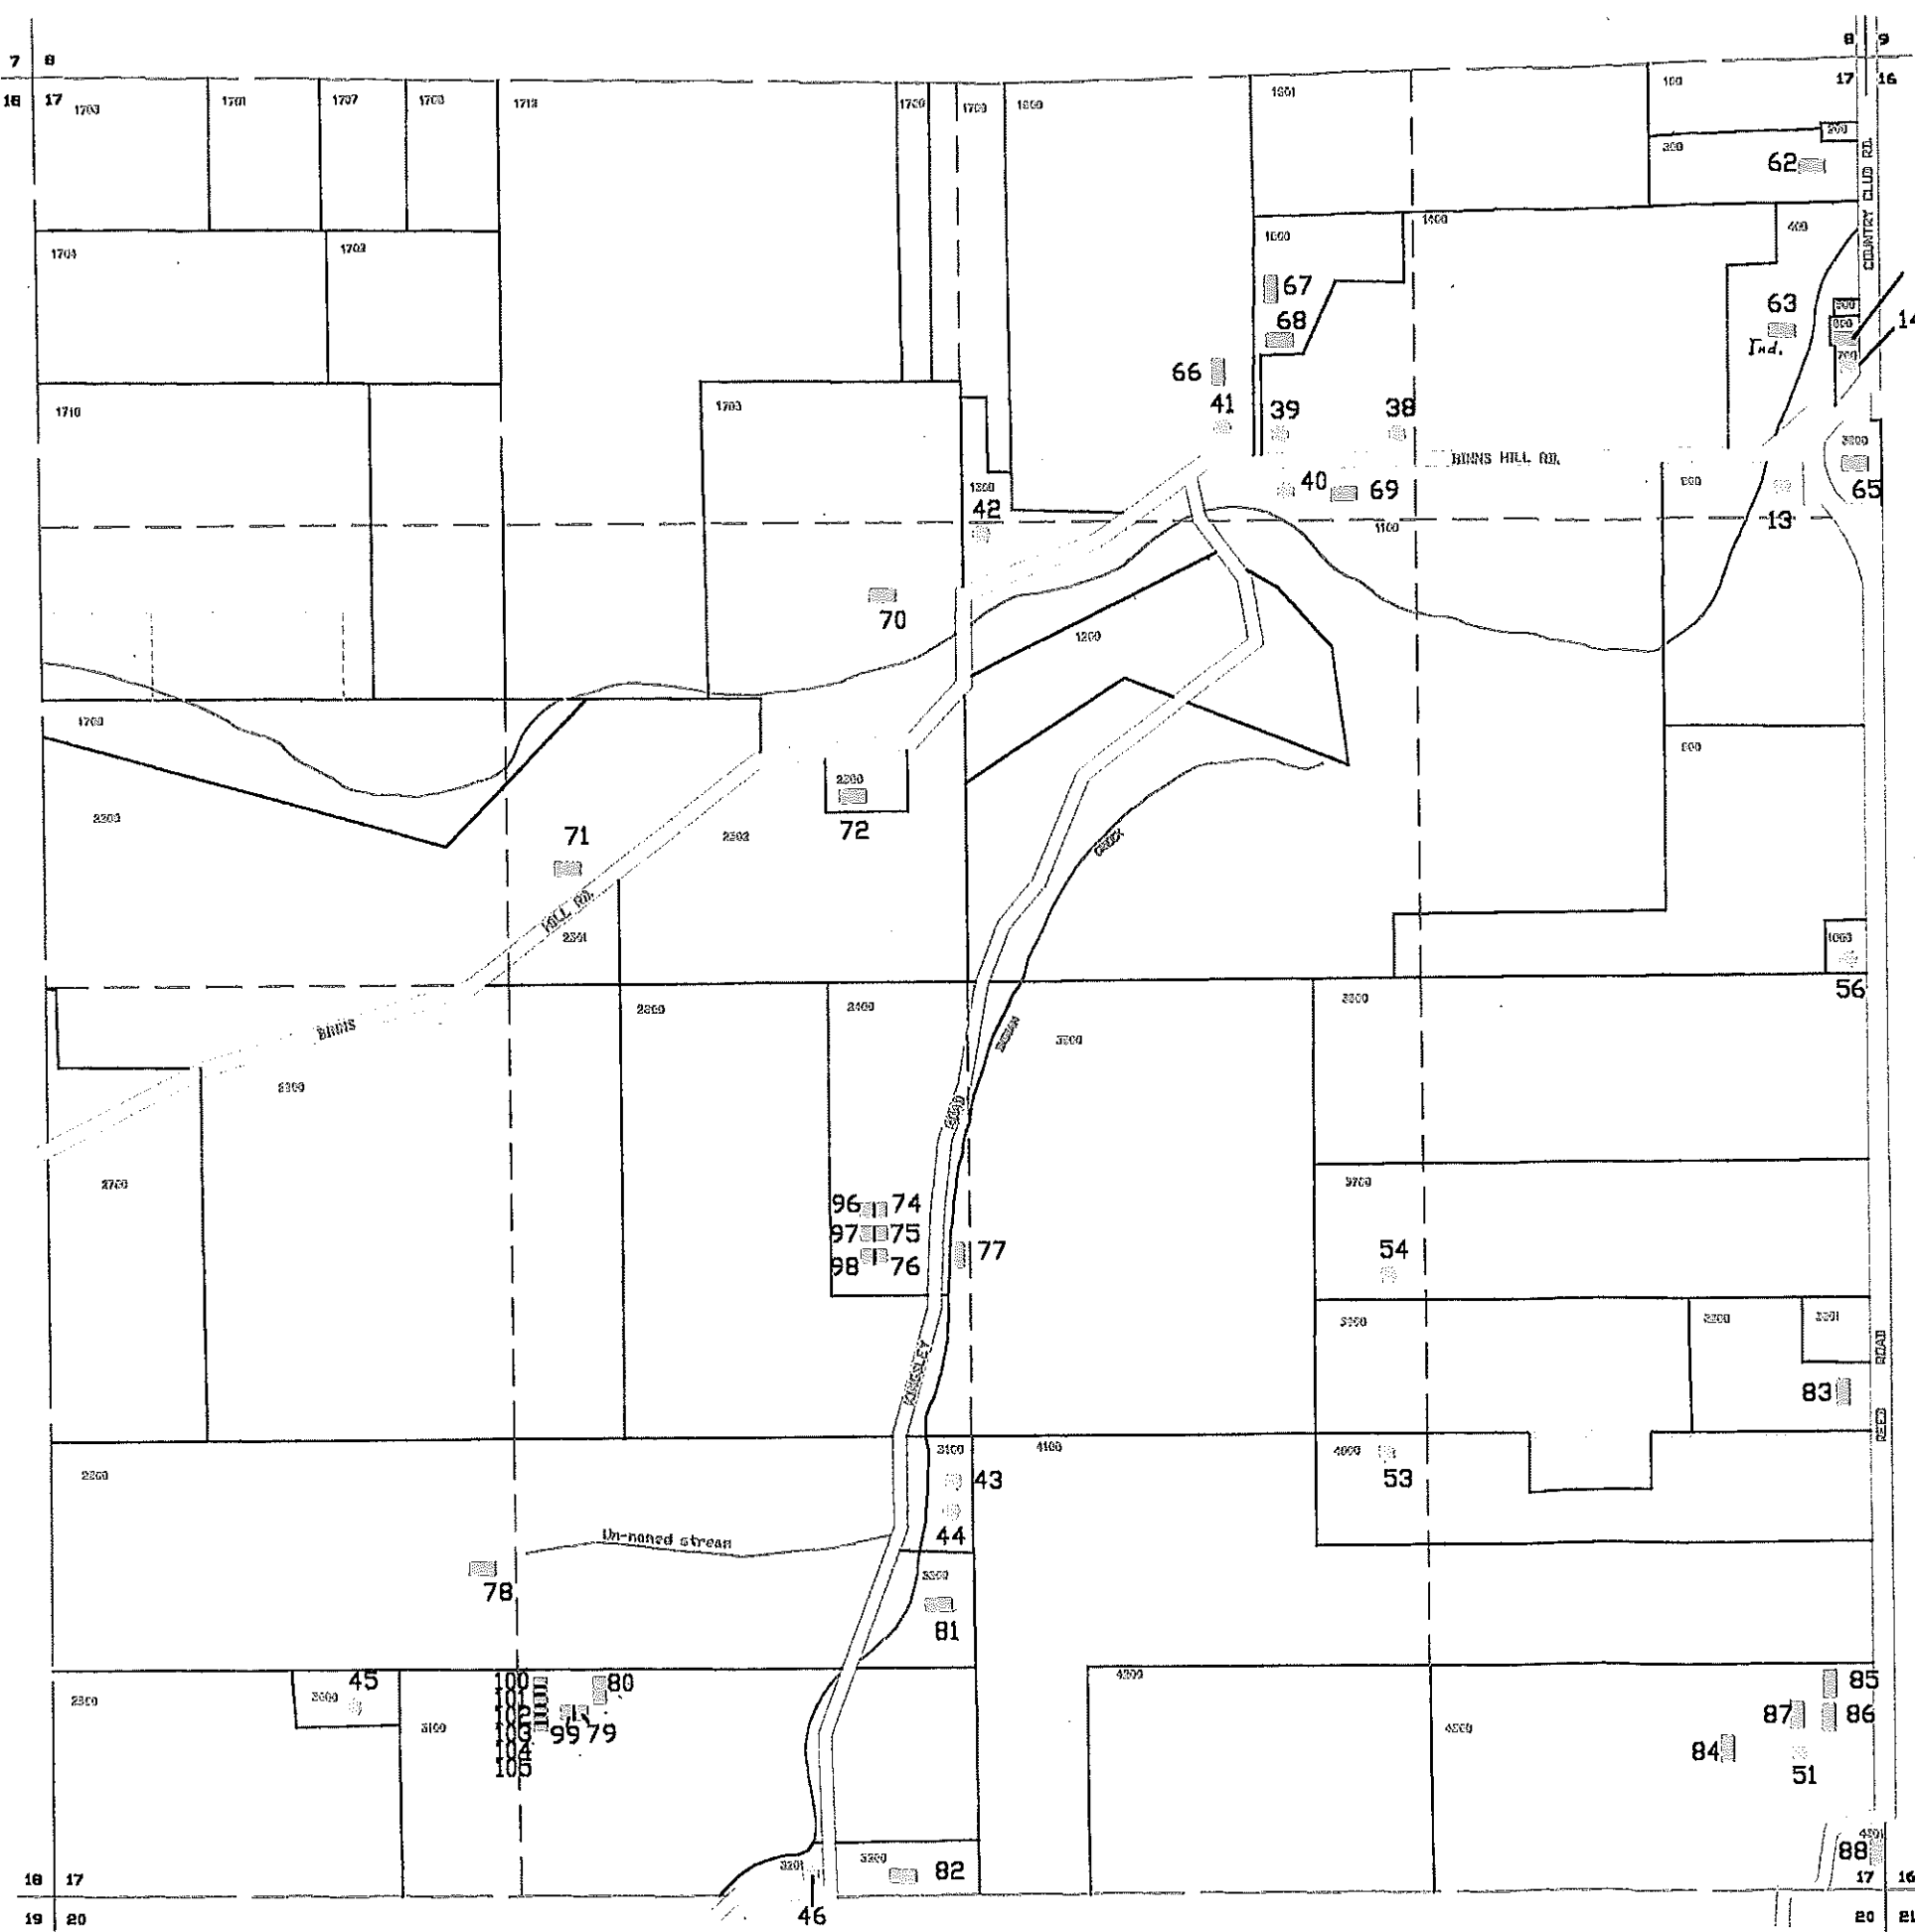

MAP SYMBOL LEGEND


- SECTION LINE
- PROPERTY LINE
- RIGHT OF WAY
- PRIVATE ROAD
- DLC LINE
- - - QTR-SECTION LINE EASEMENT
- RIVER
- CREEK
- B.P.A. EASEMENT
- PIPE

WATER RIGHT LEGEND


- Permit # 53679
- Certificate # 9151


OAK GROVE WATER COMPANY INC.  
HOOD RIVER OREGON

SECTION 17 T2N R10E  
REVISION DATE: September 1, 2000

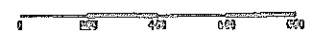

SCALE: 1" = MAP 5 of 8

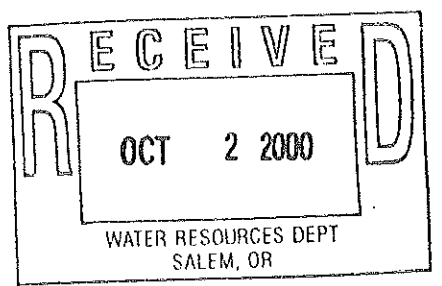

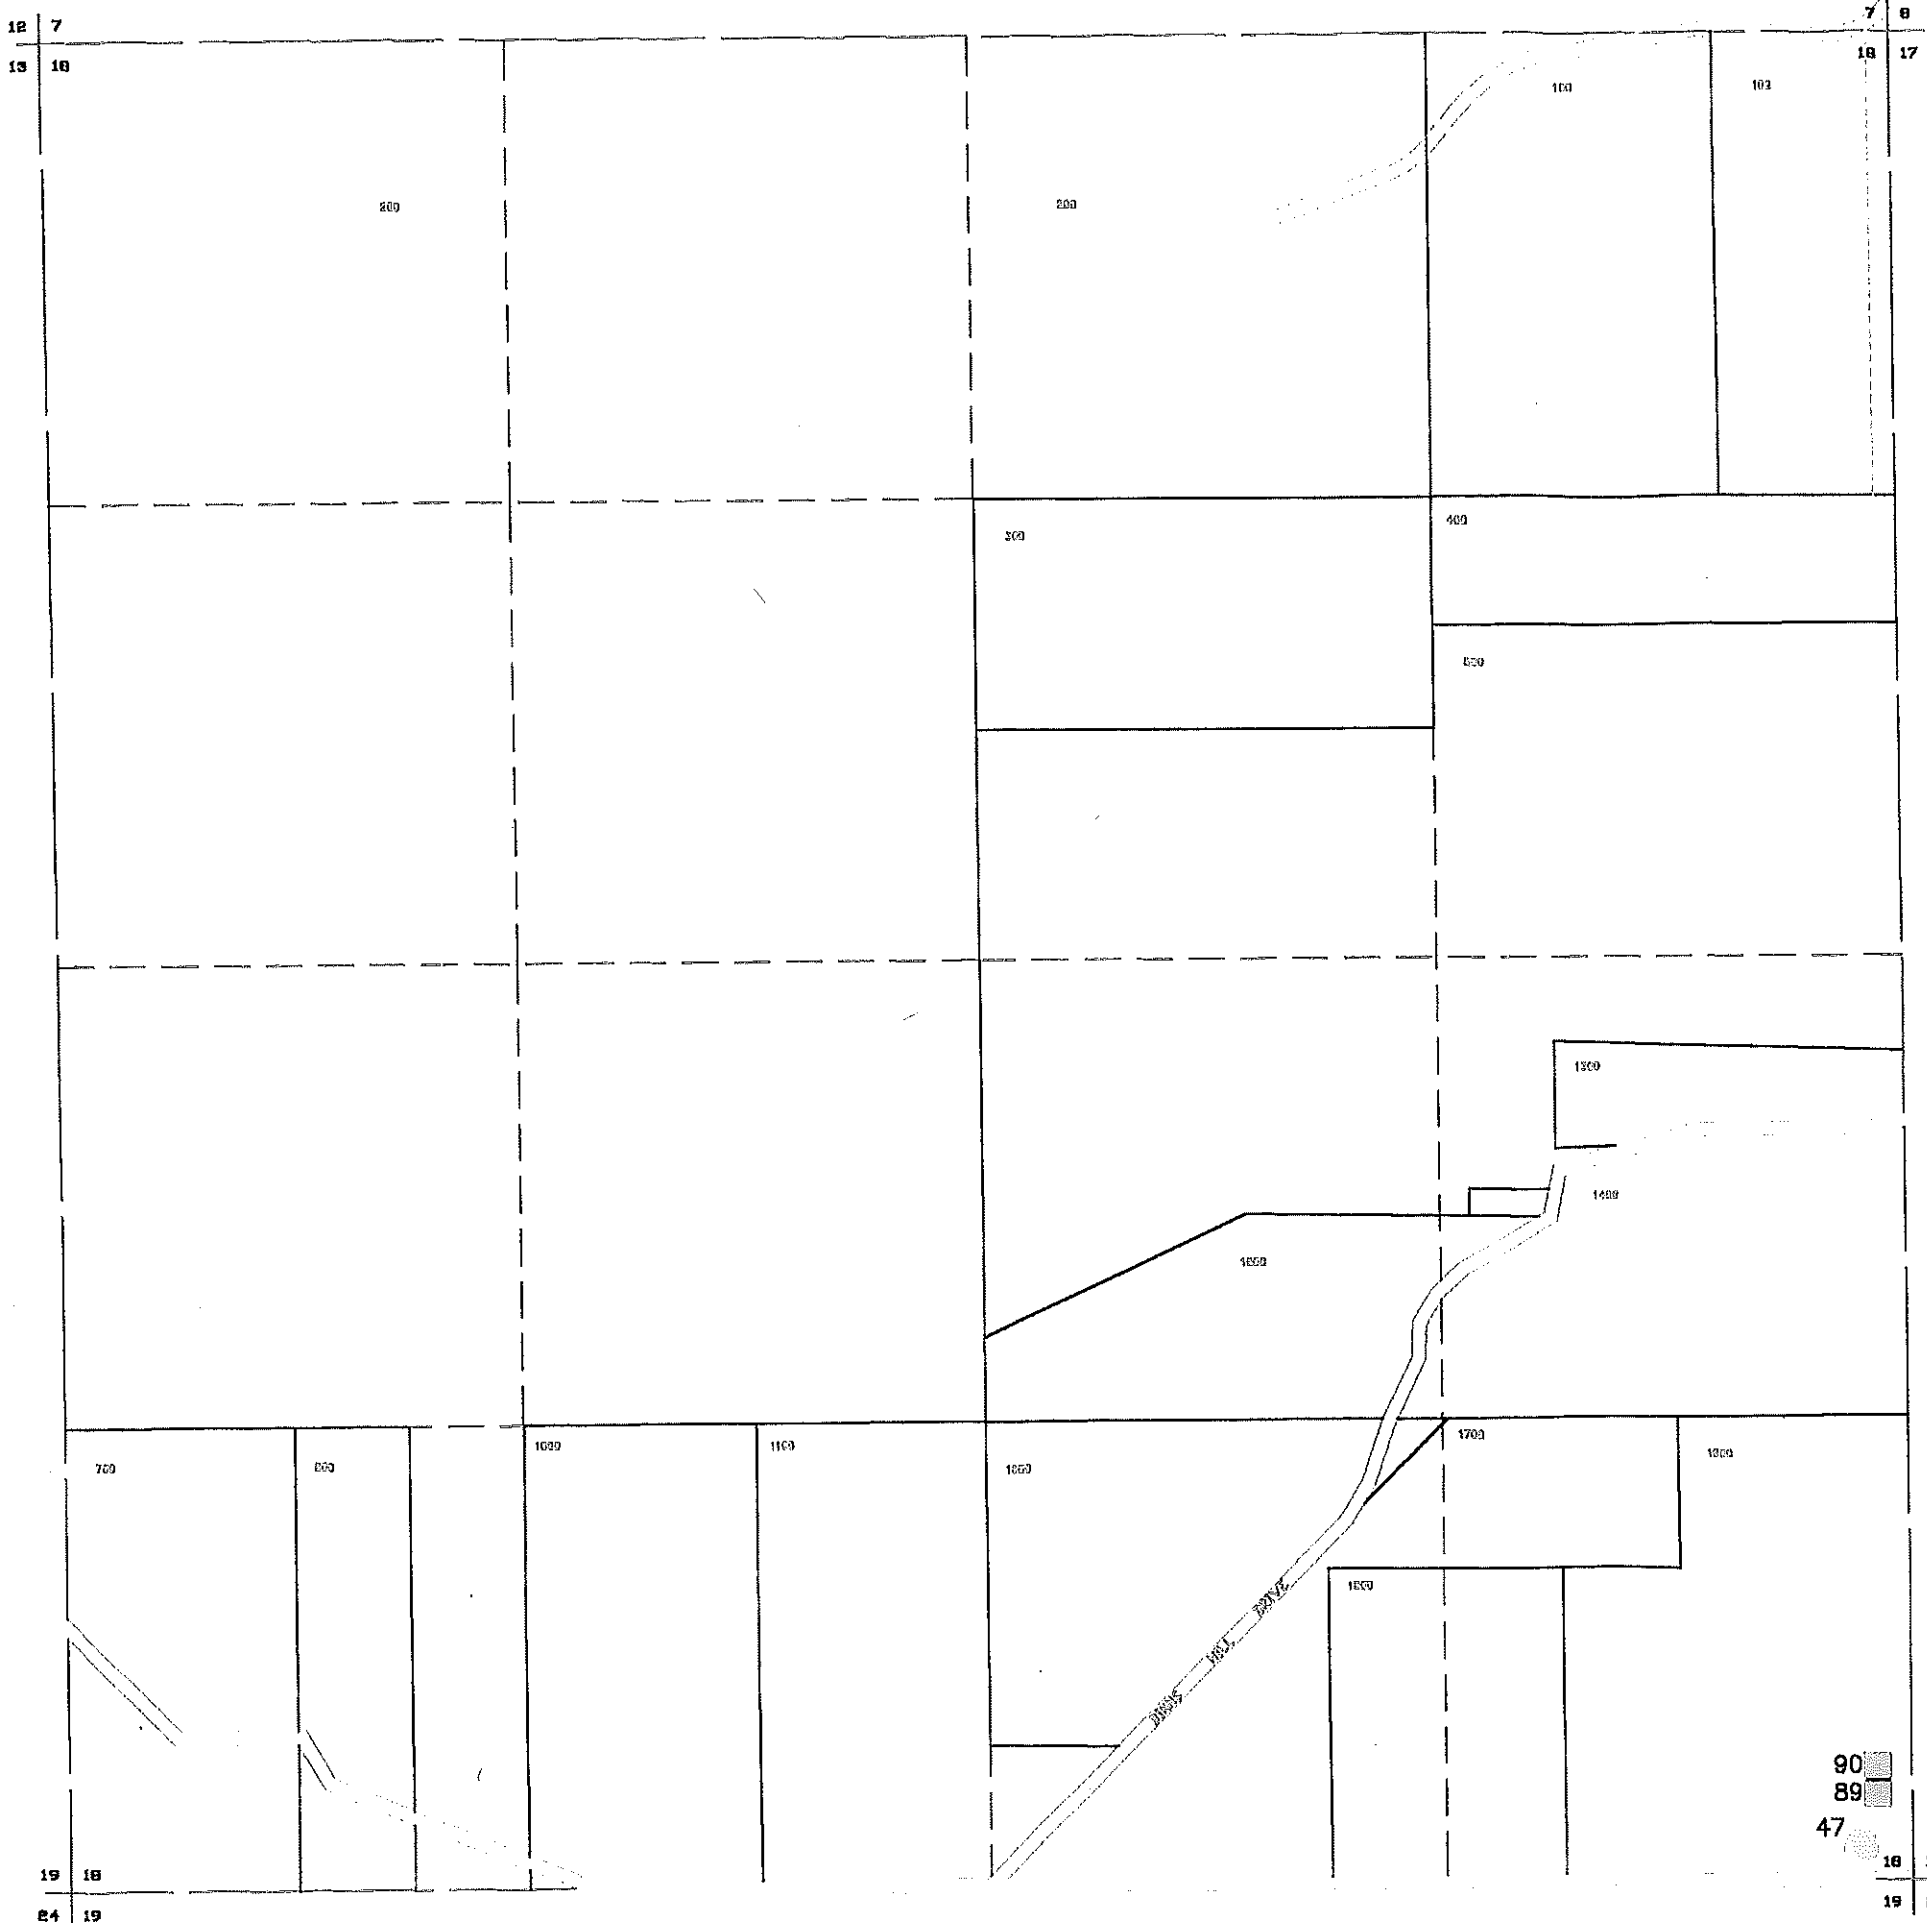

MAP SYMBOL LEGEND

- SECTION LINE
- PROPERTY LINE
- RIGHT OF WAY
- PRIVATE ROAD
- DLG LINE
- - - QTR-SECTION LINE EASEMENT
- RIVER
- CREEK
- - - B.P.A. EASEMENT
- PIPE

WATER RIGHT LEGEND

- Permit # 53679
- Certificate # 9151


OAK GROVE WATER COMPANY INC.  
HOOD RIVER OREGON



SECTION 18 T2N R10E  
REVISION DATE: August 15, 2000



SCALE: 1" = MAP 6 of 8

90  
89  
47

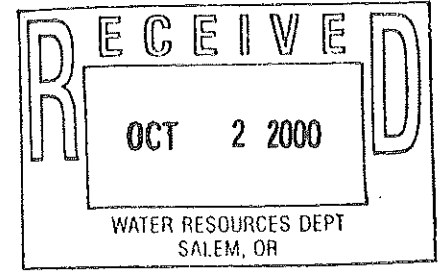

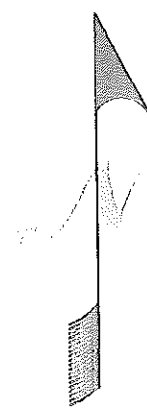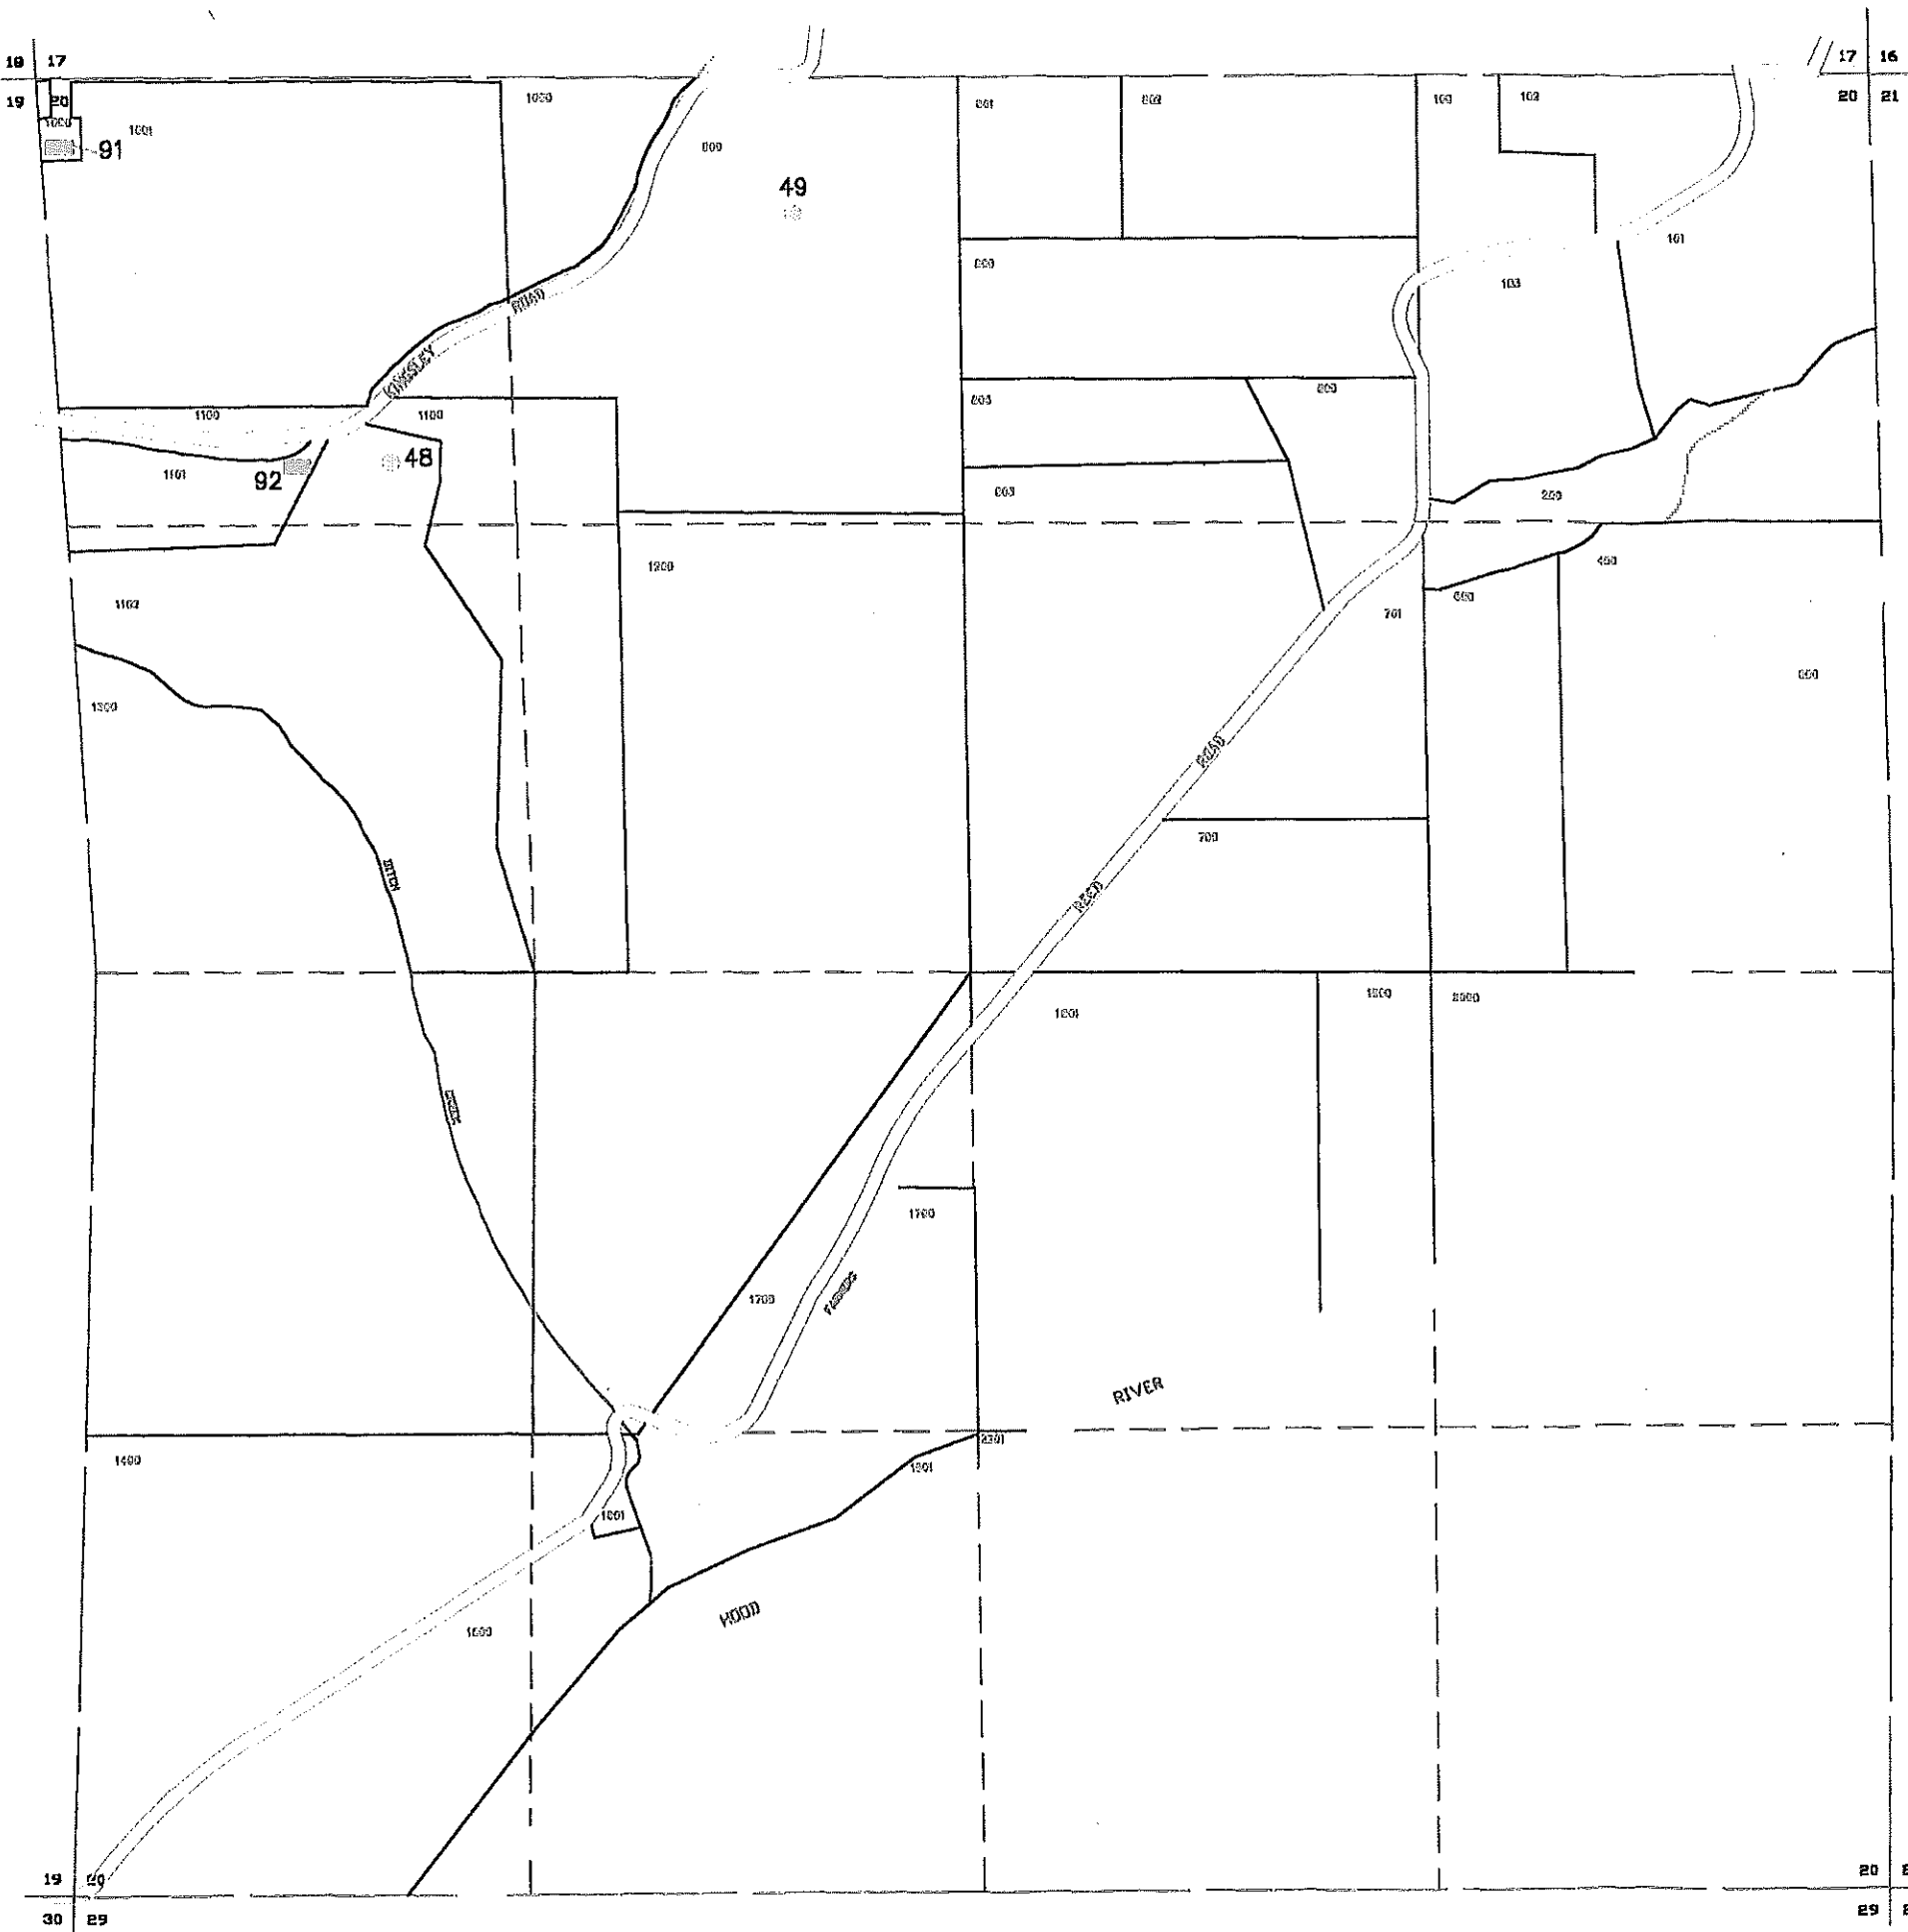

MAP SYMBOL LEGEND

- SECTION LINE
- PROPERTY LINE
- RIGHT OF WAY
- PRIVATE ROAD
- DLC LINE
- - - QTR-SECTION LINE
- - - EASEMENT
- RIVER
- CREEK
- - - B.P.A. EASEMENT
- PIPE

WATER RIGHT LEGEND


- Permit # 53679
- Certificate # 9151

OAK GROVE WATER COMPANY INC.  
HOOD RIVER OREGON



SECTION 20 T2N R10E  
REVISION DATE: September 1, 2000



SCALE: 1" = MAP 7 of 8

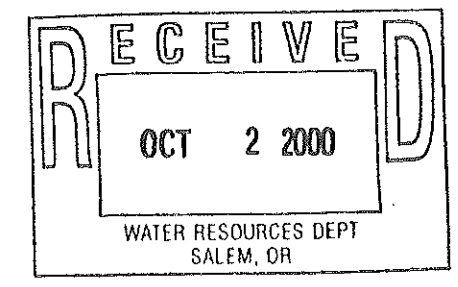



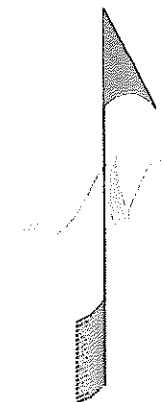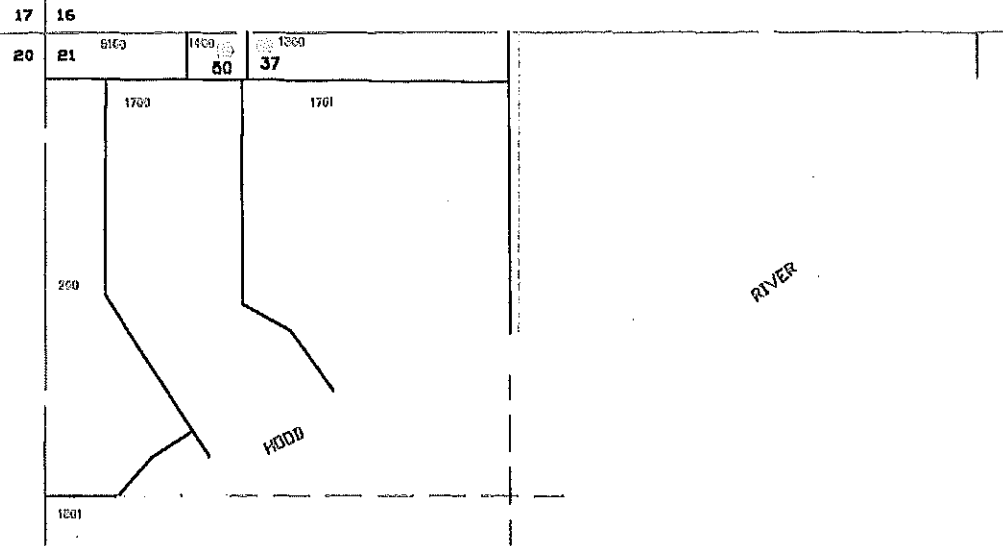

MAP SYMBOL LEGEND

- SECTION LINE
- PROPERTY LINE
- RIGHT OF WAY
- PRIVATE ROAD
- DLC LINE
- - - - QTR-SECTION LINE
- EASEMENT
- RIVER
- CREEK
- - - - B.P.A. EASEMENT
- PIPE

WATER RIGHT LEGEND

- Permit # 53879
- Certificate # 9151

OAK GROVE WATER COMPANY INC  
HOOD RIVER OREGON

SECTION 21 T2N R10E  
REVISION DATE: September 1, 2000



SCALE: 1" = MAP # of 8

